

WATER SERVICE RECORD

Name Murray Zelikoff

Service No. 238

Address 183 Cedar Street

Location

~~REPAIRS~~ - New Service

Conn. 11-8-54

Date	Material	Amount	Total	Date	Amount	
9/29/54	Labor	6 90		9-29-54	100 00	
9/30/54	Labor	2 90	9 80	11-8-54	12 50	
	10% overhead		98		87 50	
	85' - 3/4" copper tubing@ .35		29 75	9/30/54	Labor	4 00
	1 - 3/4" C x 1/2 I.W.R. stop & waste		4 00		10' - 3/4" copper tubing@.35	3 50
	1 - 3/4" Union		1 72		1 - 3/4" C. corp-cock	4 33
	5 hrs. Littlefield shovel @7.50		37 50		1 - 3/4" curb-cock	4 67
	1 hr. trucking		75		1 box end rod	3 90
	patching 3 x 3		3 00		1 - 1/2 straight tail piece	50
			87 50		1 - 1/2 offset tail piece	50
					1/2 hr. Littlefield shovel@ 7.50	3 75
					1 hr. trucking	75
						25 90


Deposited
Refunded
NON CHARGE

DATE _____

TOWN OF LEXINGTON - BOARD OF PUBLIC WORKS

WATER DIVISION

3.6 Sketch of Service Here

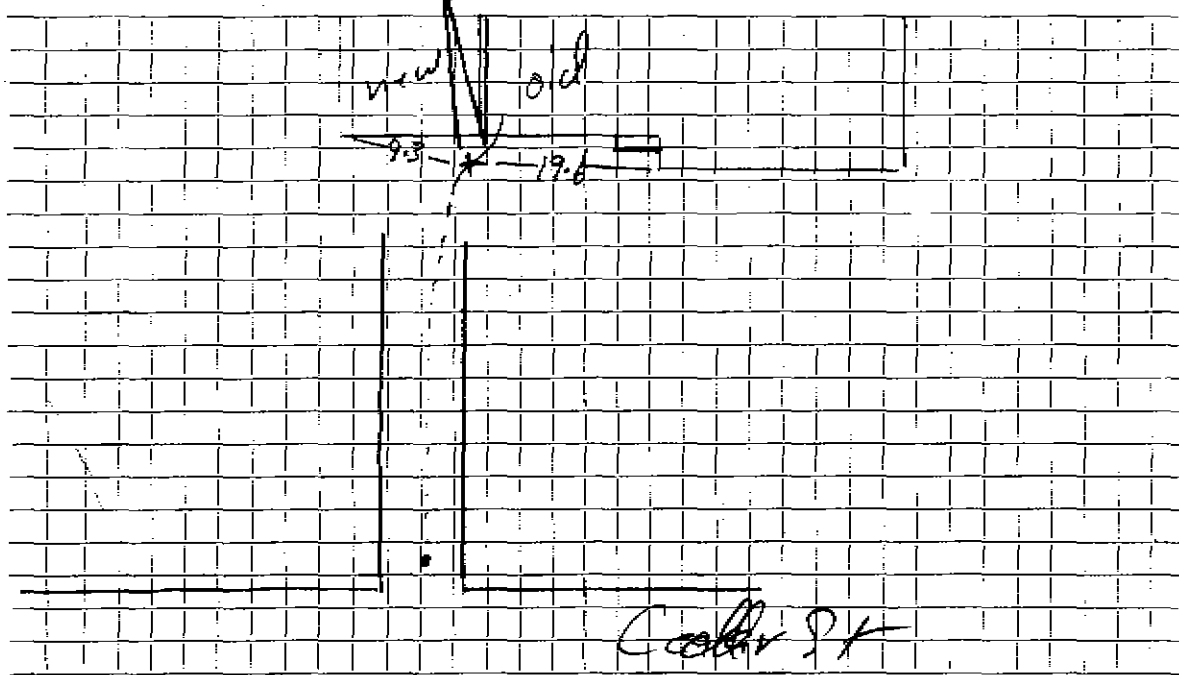

Connection made in Street. Work completed

Remarks: 3 part union installed 7/7/55 (brake solder while doing work on outside wall.)