


DATE 10-28-94

TOWN OF LEXINGTON — BOARD OF PUBLIC WORKS
WATER DIVISION

Sketch of Service Here

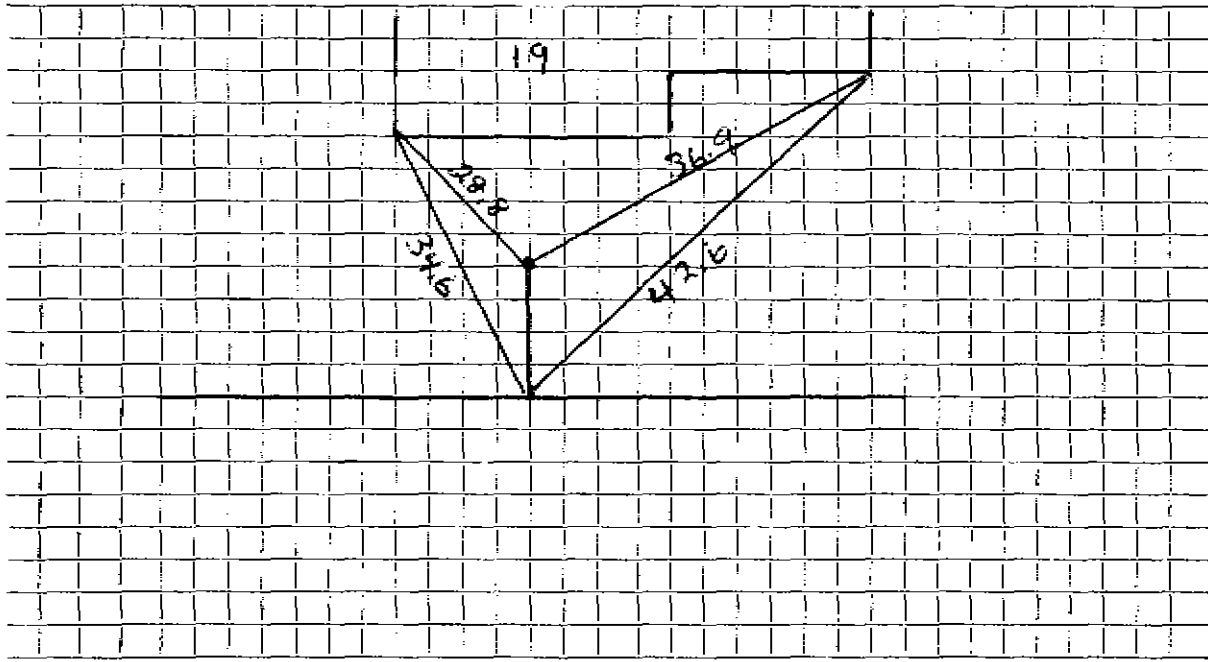

Connection made in Street. Work completed ...10-26-94.....

Remarks: From Inside