

WATER SERVICE RECORD

Name Edward B. Lloyd

Service No. 144

Address 192 Cedar Street

Location

~~Repair Record~~ New Service W.O. #8358

MAR 23 1964


Date	Material	Amount	Total	Date	Material	Amount
12-6-63	Labor	2 42		12-2-63	Deposit	100 00
	10% O.H.	24	2 66	3-23-64	Refund	51 38
89'	3/4" Copper Tubing @.42		37 38			48 62
1	3/4" CX 1/2 I.W.H. Stop & Waste		6 17			
1	3/4" C3 Part Union		2 41		NON CHARGE	
			48 62	12-6-63	21' 3/4" Copper Tubing @.42	8 82
					1 3/4" Corp Cock	4 91
					1 3/4" C Curb Cock	6 28
					1 Box & Rod	4 90
					1 1/2 Straight tailpiece	50
					1 1/2 Offset tailpiece	50
					Labor	2 31
						28 22

DATE _____

TOWN OF LEXINGTON — BOARD OF PUBLIC WORKS

WATER DIVISION

Sketch of Service Here

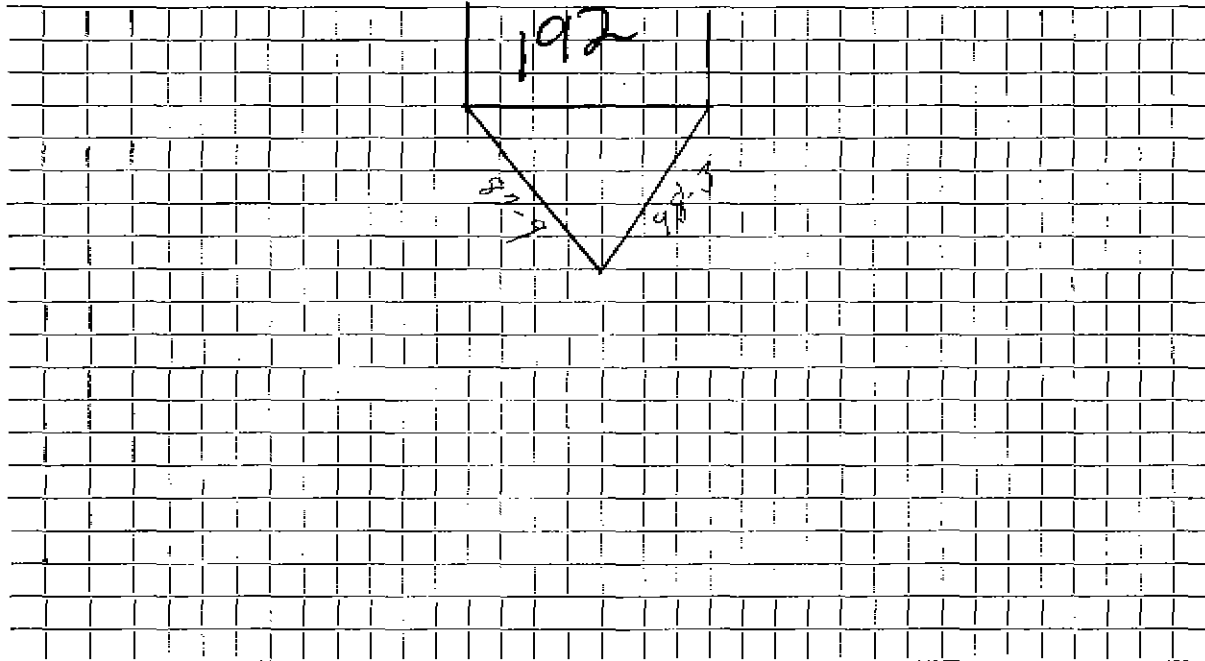

Connection made in Street. Work completed

Remarks:

.....
.....