

TOWN OF LEXINGTON - BOARD OF PUBLIC WORKS

WATER DIVISION


The undersigned applies for a supply of water at No..... St. and hereby agrees to comply with the rules and regulations as now, or at any future time, established by the Board of Selectmen.

Am't of Estimate \$..... Owner

Am't Paid \$..... Address

Builder

Sketch of Service Here

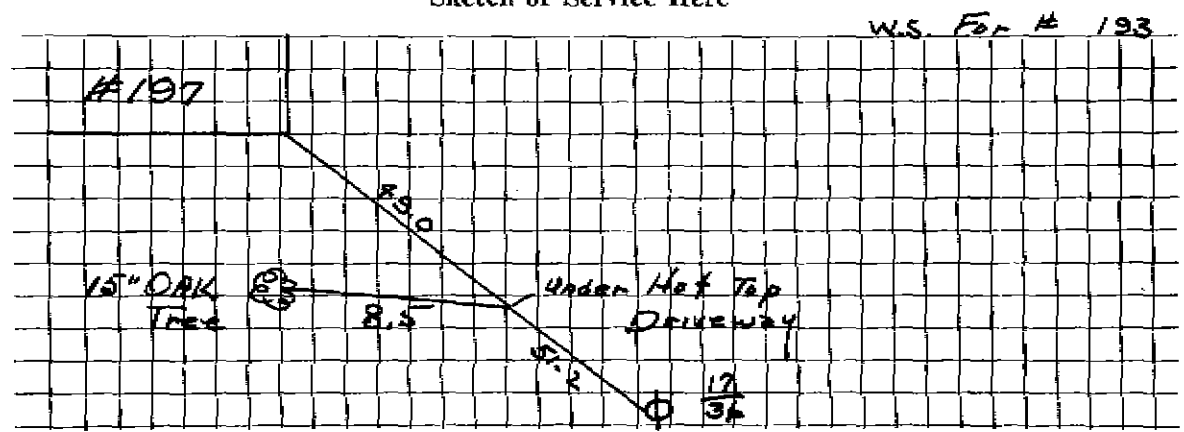

Connection made in Street. Work completed19

Remarks: