


**TOWN OF LEXINGTON - BOARD OF PUBLIC WORKS**

## WATER DIVISION

Date: 6/3/21

SKETCH OF SERVICE HERE

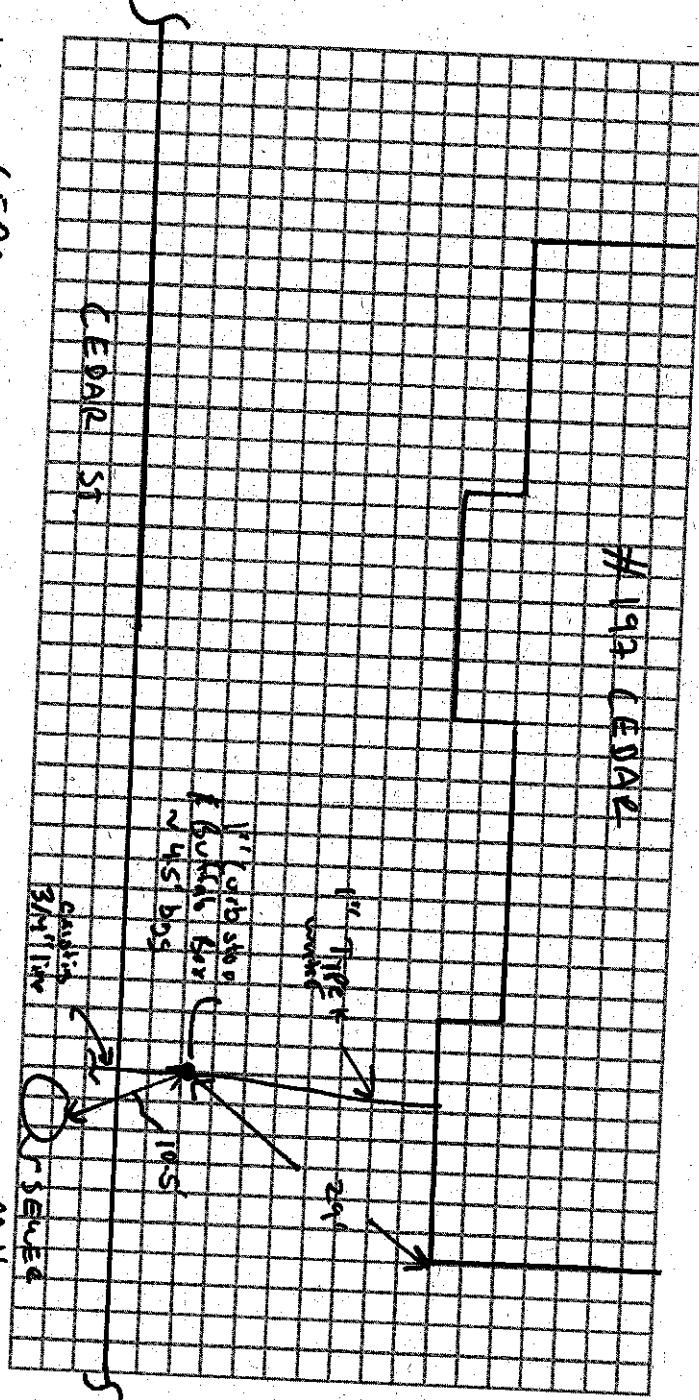

Connection made in:

2002

Street.

### Work completed:

**Remarks**

Address 197 CEDAR ST

## Location

Repair - Renewal → New Service

**WATER SERVICE RECORD**

Name Joseph L. Weber

105

Service No.

240

Address 197 Cedar Street

1068

Location Lexington, Mass.

## **REVIEWED—New Service**


Com 11-13-51

Date	Material	Amount	Total	Date		Amount
10/25/51	"abor	5 51	5 51	10/1-51	Deposited	50 00
	10% overhead		55	11-13-51	Refunded	8 89
	50' - 3/4" copper tubing @ .326	16 30			NON CHARGE	2 11
	1 - 3/4" Cx3/4" I.W.H. stop & waste	4 00	10/25/51	labor		5 51
	2 hrs. Littlefield shovel @ 7 00	14 00	5' - 3/4" copper tubing @ .326			1 63
	1 hr. trucking	75	1 - 3/4" C. corp-cock			4 33
		41 11	1 - 3/4" Cx3/4" C. curb-cock			4 67
			1 - box and rod			4 68
			1 - 1/2 straight tail piece			50
			1 - 1/2 offset tail piece			50
			1 hr. Littlefield shovel			7 00
			1 hr. trucking			75
						29 57

DATE \_\_\_\_\_

**TOWN OF LEXINGTON — BOARD OF PUBLIC WORKS  
WATER DIVISION**

Sketch of Service Here

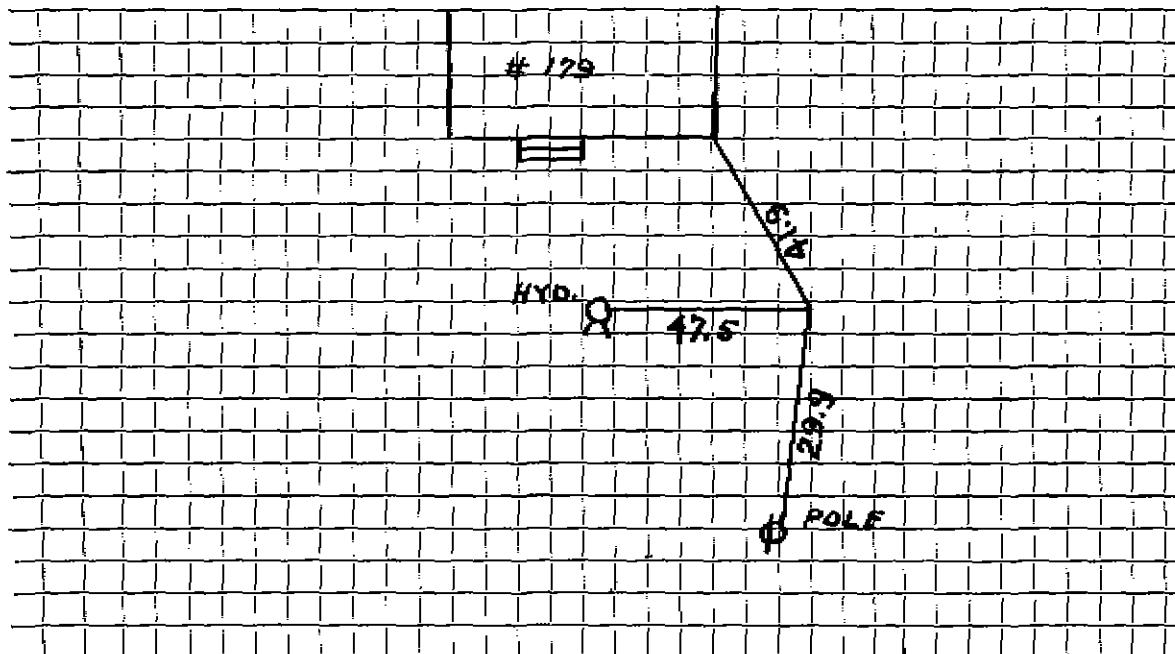

Connection made in ..... Street. Work completed .....

Remarks: .....