


DATE 2-10-98

TOWN OF LEXINGTON — BOARD OF PUBLIC WORKS

WATER DIVISION

Sketch of Service Here

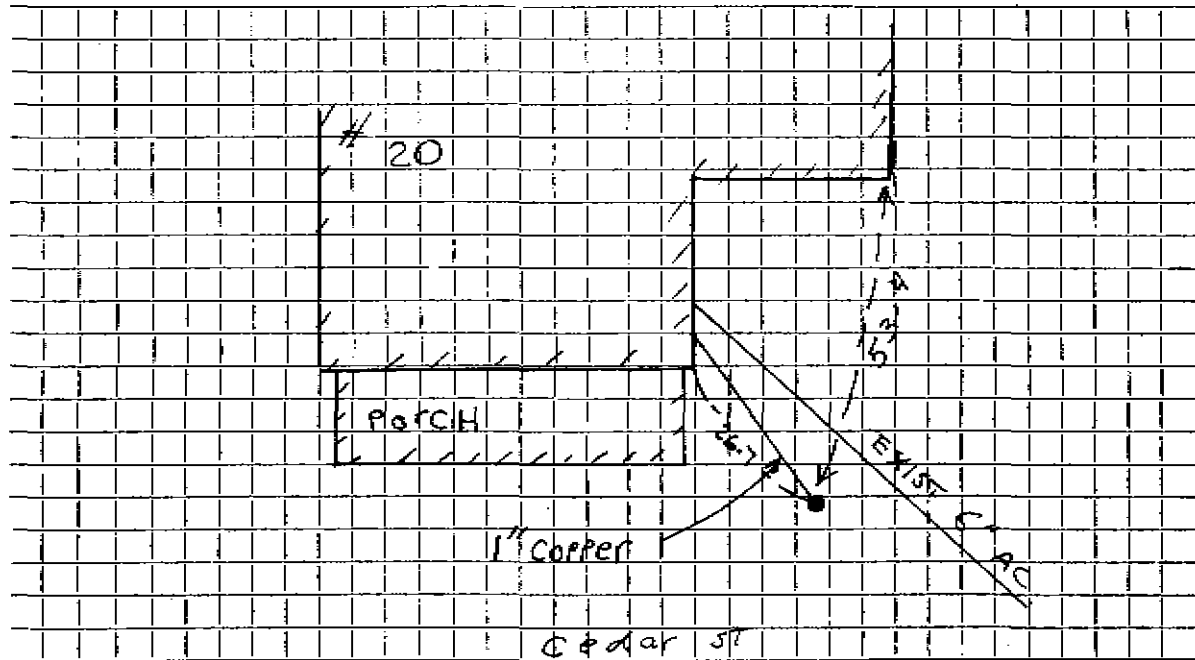

Connection made in ... Cedar St. ... Street.

Work completed ... 2-10-98 ...
BOB Gaylor INC.

Remarks:




DATE 10-28-94

TOWN OF LEXINGTON — BOARD OF PUBLIC WORKS

WATER DIVISION

Sketch of Service Here

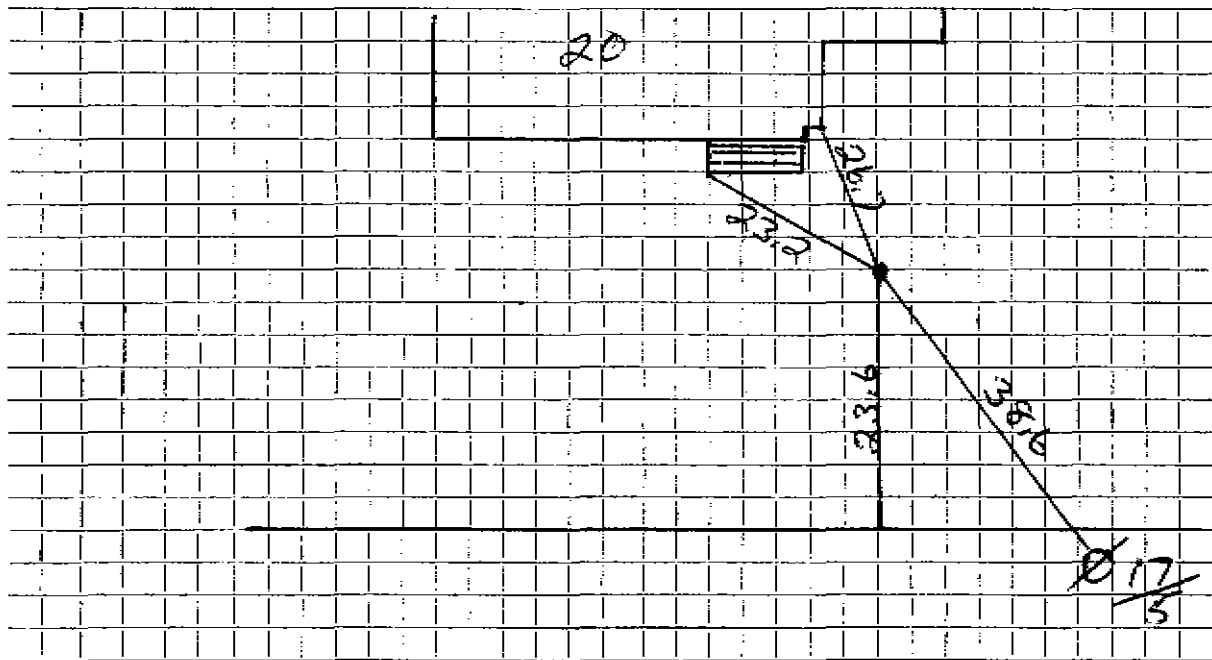

Connection made in Street. Work completed 10-27-94.....

Remarks: lead inside.....

.....
.....

WATER SERVICE RECORD

Name

Service No.

Address 20 Cedar ST

Location

Repair—Renewal—New Service

Date	Material	Amount	Total	Date	Amount
					Outside
				10-27-94	23.6 3/4 Copper
					1-3/4 Comp. Curb
					1-3/4 Comp. Corp Adpt.
					1-Style 88
					1-6" Nipple
					1 Box + Rod


10-27-94

Outside
 23.6 3/4 Copper
 1-3/4 Comp. Curb
 1-3/4 Comp. Corp Adpt.
 1-Style 88
 1-6" Nipple
 1 Box + Rod

DATE 10-28-94

TOWN OF LEXINGTON — BOARD OF PUBLIC WORKS
WATER DIVISION

Sketch of Service Here

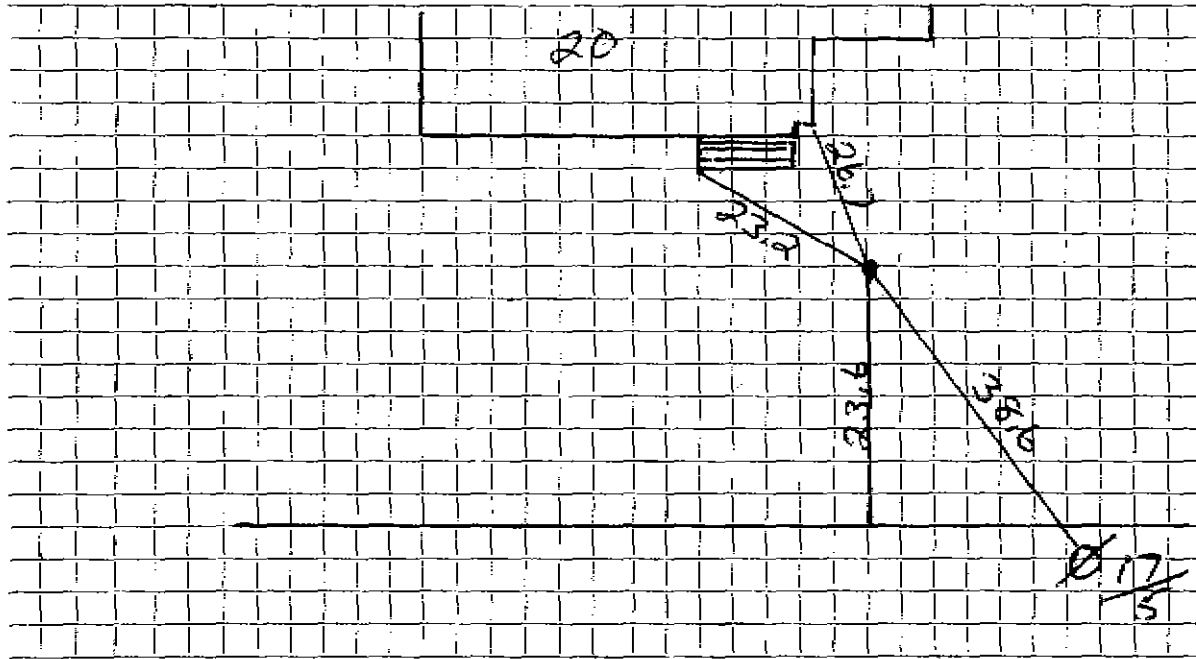

Connection made in Street. Work completed 10-27-94.....

Remarks: *lead inside*.....
.....
.....