

Name Paul Lloyd

Service No. 98H 498

Address 202 Cedar Street

Location 202 Cedar Street

Kind of Pipe Size Size of Main

~~Repair - Renewal~~ - New Service Com. 8-15-49

Location

Date	Material	Amount	Total	Date	Amount
June 22, '49	Labor	12 25	12 25	<i>June 20 '49 Deposited</i>	275 00
	Labor	8 00	8 00		
	10% Overhead		2 03	<i>Aug 25 '49 Refunded</i>	<u>71 10</u>
	300' - 1" Copper Tubing @.30		90 00	June 24, '49 Labor	9 15
	1 - 1" C x 1" I.W.H. S&W		4 23	18' - 1" Copper Tubing @.30	5 40
	4 - 1" C x 1" C Union @1.83		7 32	1 - 1" C Corp-cock	4 62
	Littlefield Shovel 6½ hrs.		45 50	1 - 1" C x 1" C Curb-cock	5 50
	Trucking 2 hrs. @.75		1 50	2 - 1" C x 1" C Union @1.83	3 66
	Patching 13 x 3		13 00	1 - Box & Rod	3 95
			183 83	1 - Pit Cover & Frame	8 65
				2 - 1" Offset Tail Pieces	74
				Littlefield Shovel 2½ hrs.	17 50
	Labor			Hough Loader 1 hr.	3 00
				Trucking 1 hr.	75
					<u>62 92</u>

DATE _____

TOWN OF LEXINGTON - BOARD OF PUBLIC WORKS

WATER DIVISION

The undersigned applies for a supply of water at No..... St. and hereby agrees to comply with the rules and regulations as now, or at any future time, established by the Board of Selectmen.

Am't of Estimate \$.....


Owner

Am't Paid \$.....

Address

Builder

Sketch of Service Here

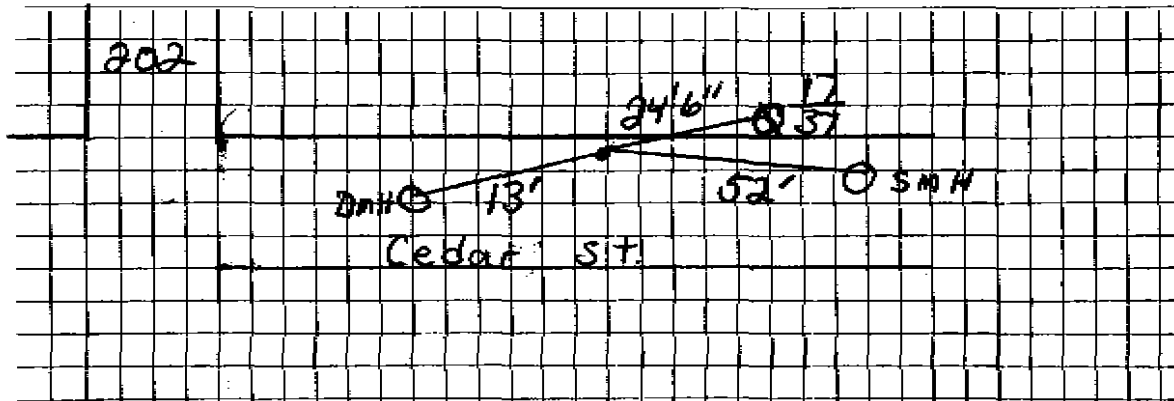

Connection made in Street.

Work completed19

Remarks: Removed old Pit. 3'6" deep 1" Copper
Freeze-up

