

WATER SERVICE RECORD

Name Paul D. Lloyd

Service No. 33

Address 204 Cedar St.

Location W.O. #1185

Repair—Renewal—New Service Kal-Scot # 2339

FEB 10 1975


Date	Material	Amount	Total	Date	Amount	
8/17/73	Labor	28.08		8-15-73	Deposit	101.00
	10 % O.H.	2.81	30.89	2-16-75	Paid by SHCA # 90	41.14
97'	1" Copper tubing @ .77		74.69			141.14
1	1" Corp Cock		13.79			
1	1" Curb Cock		14.43			
1	Box & Rod		7.34			
			141.14			
9/18/73	90' 1" Copper tubing					

DATE _____

TOWN OF LEXINGTON — BOARD OF PUBLIC WORKS

WATER DIVISION

Sketch of Service Here

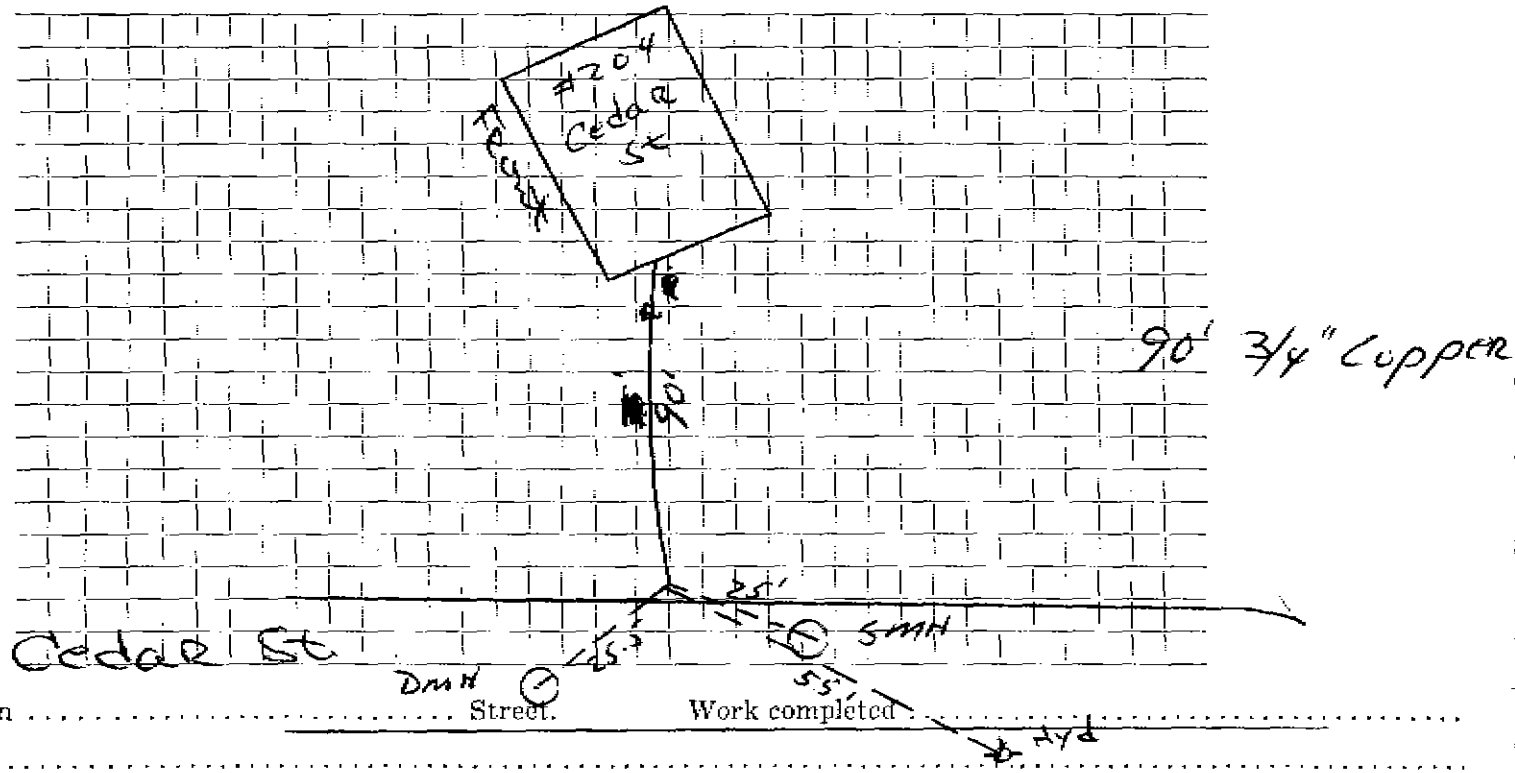

Connection made in Street. Work completed

Remarks:

.....

.....