

WATER SERVICE RECORD

Name

Service No.

Address 24 Cedar St.

Location

~~Repair~~—Renewal—~~New Service~~


Date	Material	Amount	Total	Date	Amount
10/6	90' 1" Pipe @ .20	1 80		8/2	Deposit 10 00
	2 1" Ells @ .15	30			
	2 1" Nipples @ .10	20			
	1 Stw	2 75			NON CHARGE
	Trucking	75		11/17/53	Labor 27 65
	Construction Chge	3 00		24'-3/4" Copper Tubing @ .3629	8 71
	2 hrs labor @	1 20		1-3/4" C. Adapter	1 95
			10 00	1-3/4" C x 3/4" J. Curb-cock	4 67
				4 Ers. Littlefield Shovel @7.50	30 00
				1 Er. Trucking	75
				Patching 18 x 3	18 00
					91 73

DATE _____

TOWN OF LEXINGTON — BOARD OF PUBLIC WORKS

WATER DIVISION

Sketch of Service Here

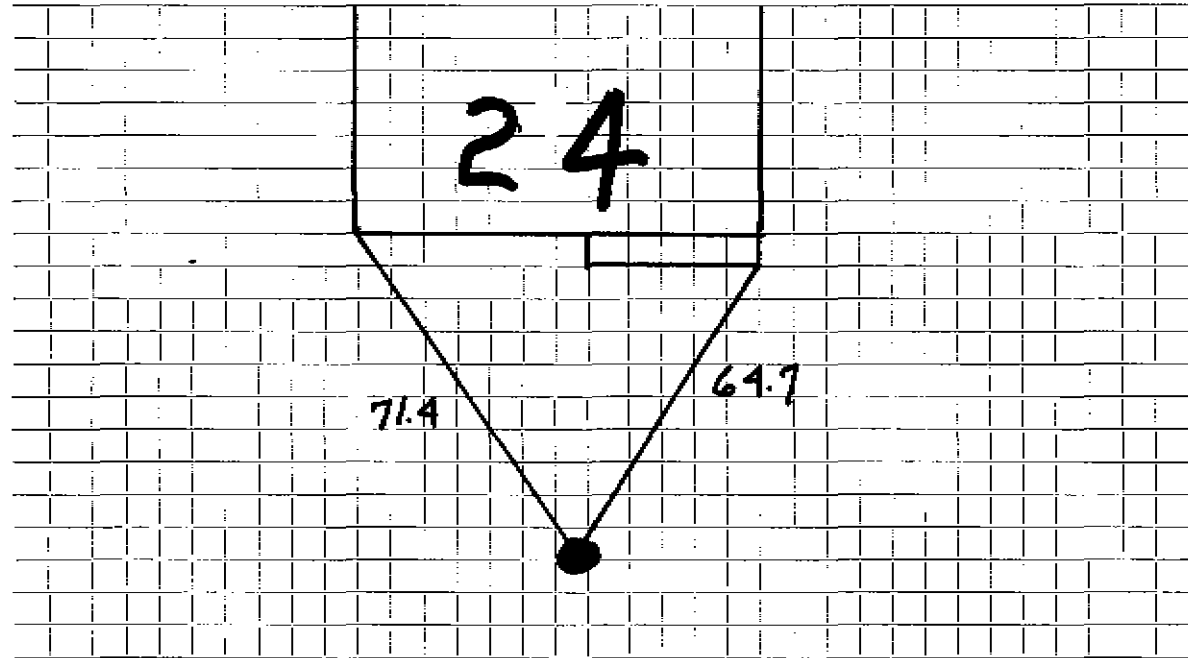

Connection made in Street. Work completed

Remarks:

.....

.....