




WATER DIVISION

Sketch of Service Here

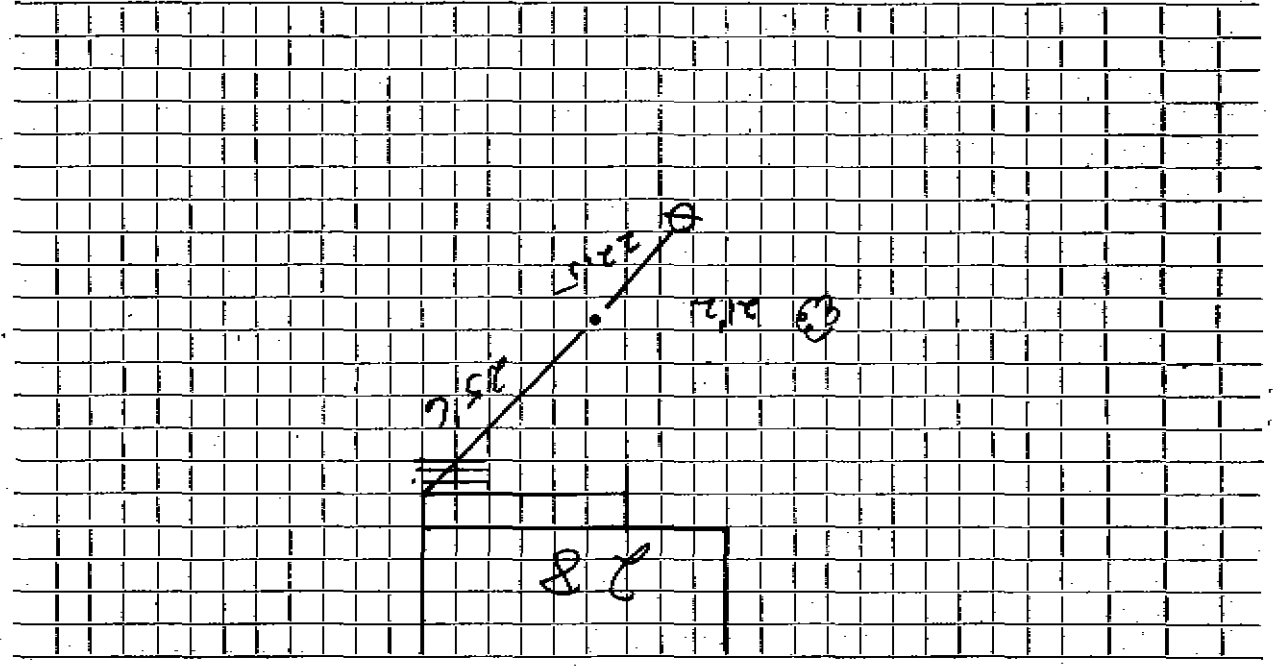

Street. Work completed

Connection made in

Remarks: