


DATE MAY 9, 1997

TOWN OF LEXINGTON — BOARD OF PUBLIC WORKS
WATER DIVISION

Sketch of Service Here

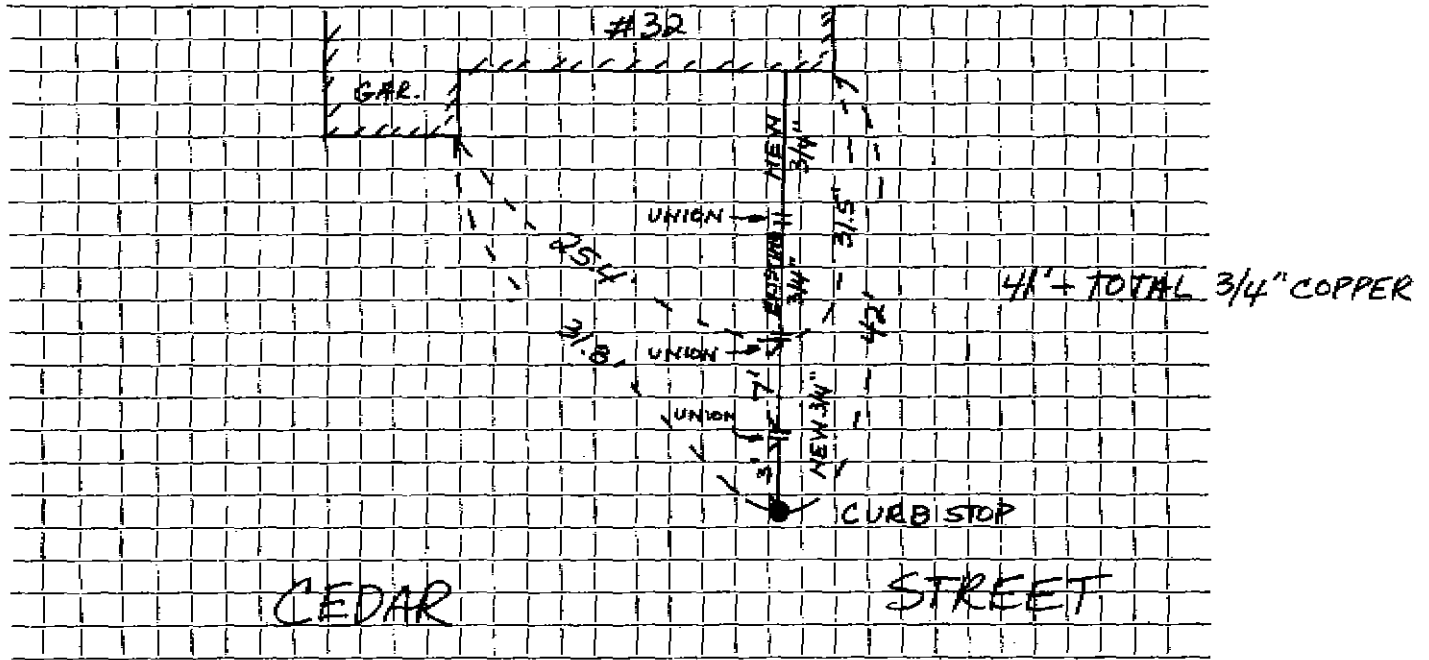

Connection made in CEDAR STREET Street. Work completed

Remarks: