

WATER SERVICE RECORD

3201

Name Joseph M Cerrillo

Service No. 158

Address 37 Cedar Street

#7323

Location Lexington, Mass.


~~Repair-Renewal~~ New Service Com. 10-1-51

Date	Material	Amount	Total	Date	Amount
8-15-51	Labor	1 49	1 49	7-12-51 Deposited	20 00
	10% Overhead		15	10-1-51 Refunded	1 28
	38'- 3/4" Copper Tubing @ .326	12 38			18 57
	1-3/4" Cx 1/2 I.W.H. S&W	4 00		No Charge	
	1 Hr. Trucking		75	8-15-51 Labor	1 49
			18 77	10'- 3/4" Copper Tubing @ .326	3 26
				1- 3/4" C. Corp Cock	4 33
				1-3/4" C x 3/4" C. Curb Cock	4 67
				1- Box & Rod	4 68
				1-1/2 Offset Tail Piece	50
				1-1/2 Straight Tail Piece	50
				1 Hr. Trucking @ .75	75
					20 18

DATE \_\_\_\_\_

TOWN OF LEXINGTON — BOARD OF PUBLIC WORKS  
WATER DIVISION

Sketch of Service Here

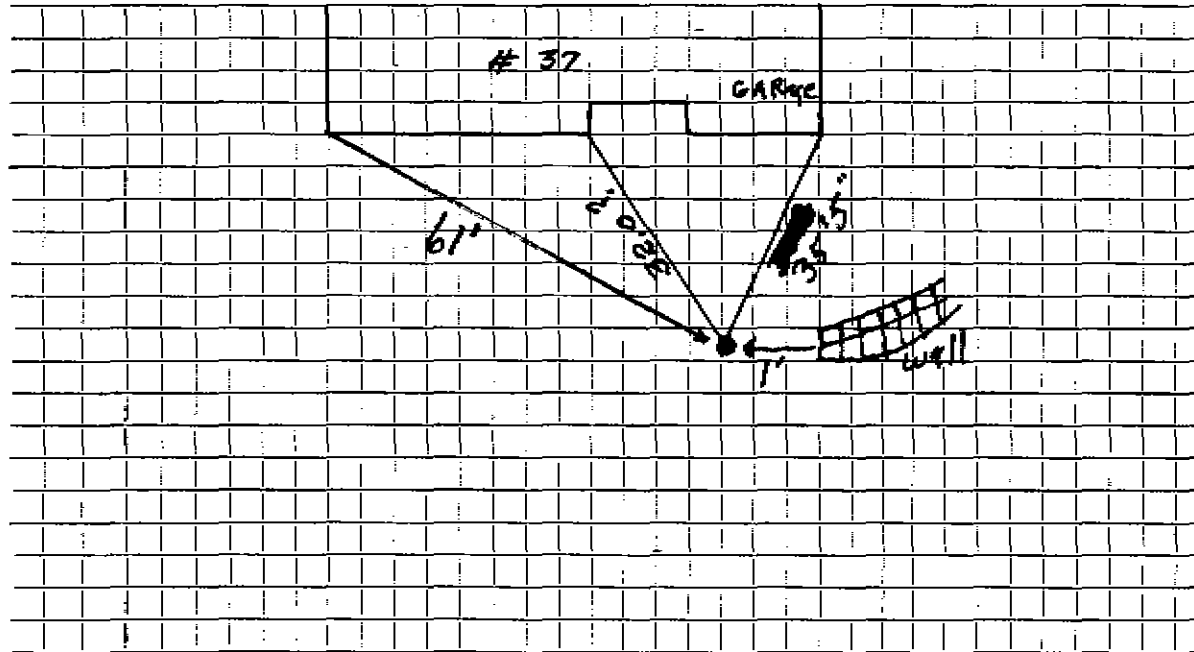

Connection made in ..... Street ..... Work completed .....

Remarks: .....  
.....  
.....