

Name **Mary Craddock**
 Address **38 Cedar Street**

Service No. **501**

6673

Location **38 Cedar Street**

Kind of Pipe

Size

Size of Main

~~Repair~~—Renewal—~~REPAIR~~

Location

Date	Material	Amount	Total	Date	Amount
Aug. 25, '47	Labor	1 10	1 10	Aug 25 '47	10 00
	10% Overhead		11	April 12 '48	1 87
	26' - 3/4" Copper Tubing @.26	6 76	6 76		11 87
	1 - 3/4" C x 1/2" I.W.H. S & W	3 15	3 15	Aug. 25, '47 Labor	22 30
	Trucking 1 hr. @.75		75	10' - 3/4" Copper Tubing @.26	2 60
			11 87	1 - 3/4" C Corp-cock	3 00
				1 - 3/4" C x 3/4" C Curb-cock	3 68
				1 - Box & Rod	4 26
				1 - 1/2" Offset Tail Piece	30
					36 14

*Deposited
 Paid*

Non-Charge

Bill for 1-8-48

Labor

TOWN OF LEXINGTON - BOARD OF PUBLIC WORKS
WATER DIVISION

The undersigned applies for a supply of water at No..... St. and hereby agrees to comply with the rules and regulations as now, or at any future time, established by the Board of Selectmen.

Am't of Estimate \$.....


Owner

Am't Paid \$.....

Address

Builder

Sketch of Service Here

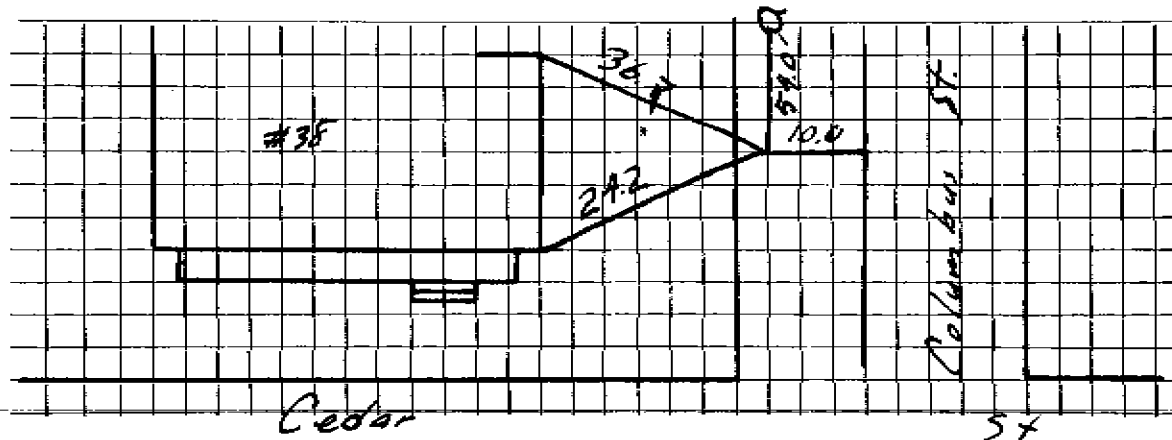

Connection made in Street.

Work completed19

Remarks: