

WATER SERVICE RECORD

Name Jesse Curra

Service No.

316

Address 44 Cedar St.


Location Lexington

Repair - Renewal ~~NEW WORK~~ COM. 12-8-52

Date	Material	Amount	Total	Date	Amount
11/24/52	Labor	14 48		11-18-52	Deposited 30 10
	10% overhead	1 45	15.93	12-8-52	Refunded (82
	25' - 3/4" copper tubing @ .34	8.50			NON CHARGE 29 18
	1 - 3/4" Cx 1/2 I.W.H. stop & waste	4.00		11/24/52	Labor 46 00
	1 hr. trucking	.75		18' - 3/4" copper tubing @ .34	6 12
			29.18	1 - 3/4" C. corp-cock	4 33
				1 - 3/4" C x 3/4" C. curb-cock	4 67
				1 box and rod	3 90
				1 - 1/2 offset tail pc.	50
				1 - 1/2 straight tail pc.	50
				1 hr. trucking	75
					66 77

TOWN OF LEXINGTON — BOARD OF PUBLIC WORKS
WATER DIVISION

Sketch of Service Here

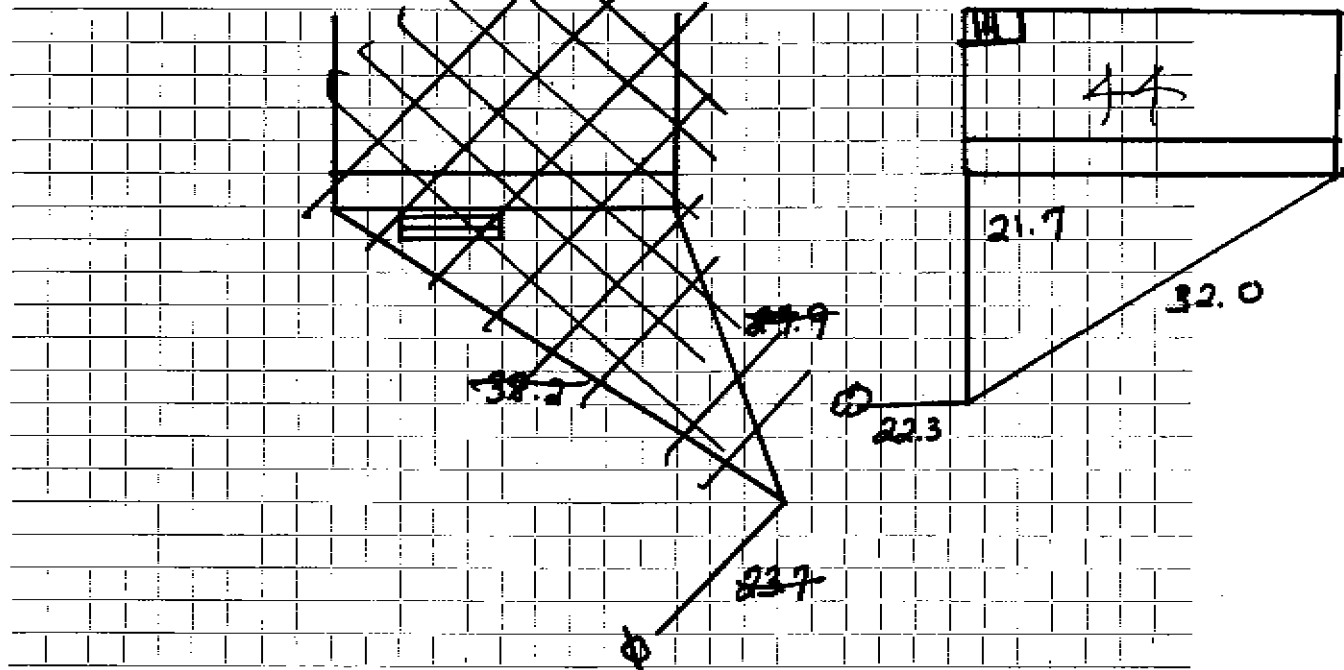

Connection made in Street. Work completed

Remarks:

.....

.....