


DATE 9/1/94

TOWN OF LEXINGTON — BOARD OF PUBLIC WORKS

WATER DIVISION

45 CEDAR ST.

Sketch of Service Here

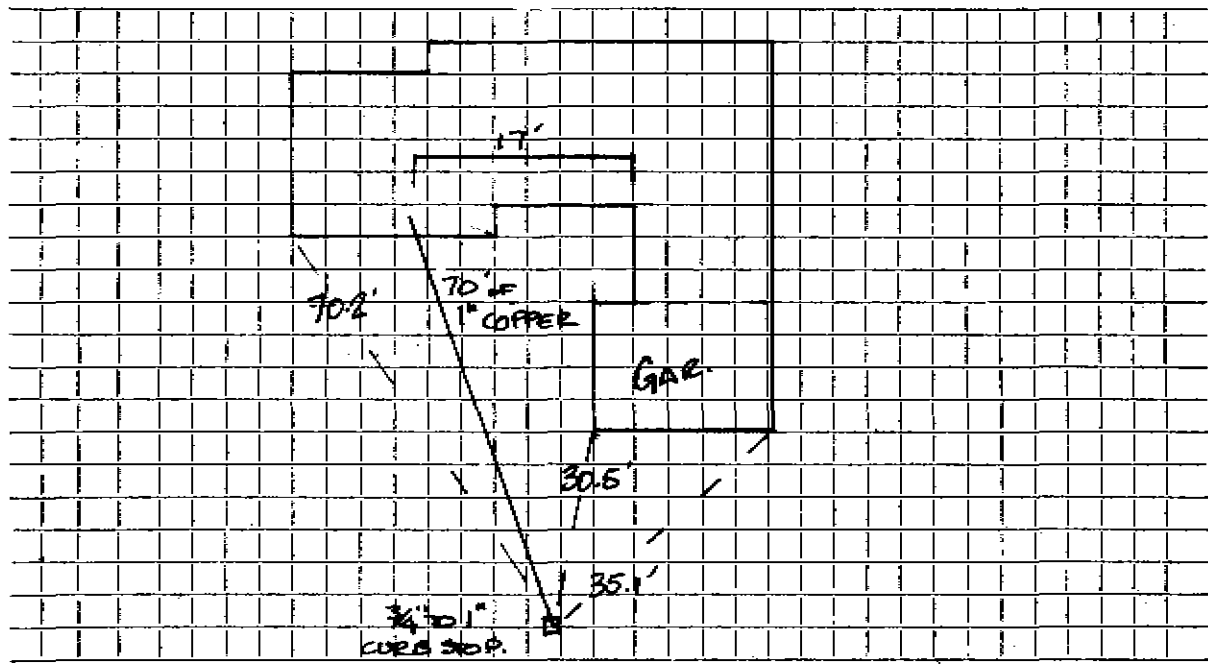

Connection made in CEDAR ST. Street. Work completed

Remarks:
.....
.....