

Name John Curra  
 Address 48 Cedar Street

Service No. #4876

Location 48 Cedar Street

Kind of Pipe \_\_\_\_\_ Size \_\_\_\_\_ Size of Main \_\_\_\_\_

~~Repair & Renewal~~ - New Service Com. 9-19-49 Location \_\_\_\_\_

Date	Material	Amount	Total	Date	Amount
Jul. 19, '49	Labor	1 25	1 25	<i>July 19, '49 Deposited</i> <i>Sept 21 '49 Refunded</i>	26 00
	10% Overhead		13		2 38
	30' - 3/4" Copper Tubing @.24	7 20	7 20	Non-Charge	17 62
	1 - 3/4" C x 1/2" I.W.H. S&N	3 29	3 29	Jul. 19, '49 Labor	5 85
	Trucking 1 hr.		75	12' - 3/4" Copper Tubing @.24	2 88
	Patching 5 x 3		5 00	1 - 3/4" C Corp-cock	3 15
			17 62	1 - 3/4" C x 3/4" C Curb-cock	3 85
				Box & Rod	3 95
				2 - 1/2" Straight Tail Piece @.37	74
				Littlefield Shovel @7.00	14 00
				Trucking 1 hr.	75
				4/3/96 17'-1" Copper	35 17
	Labor			Repair 1 - Coupling	

TOWN OF LEXINGTON – BOARD OF PUBLIC WORKS  
**WATER DIVISION**


The undersigned applies for a supply of water at No. .... St. and hereby agrees to comply with the rules and regulations as now, or at any future time, established by the Board of Selectmen.

Am't of Estimate \$..... Owner .....

Am't Paid \$..... Address .....

Builder .....

Sketch of Service Here

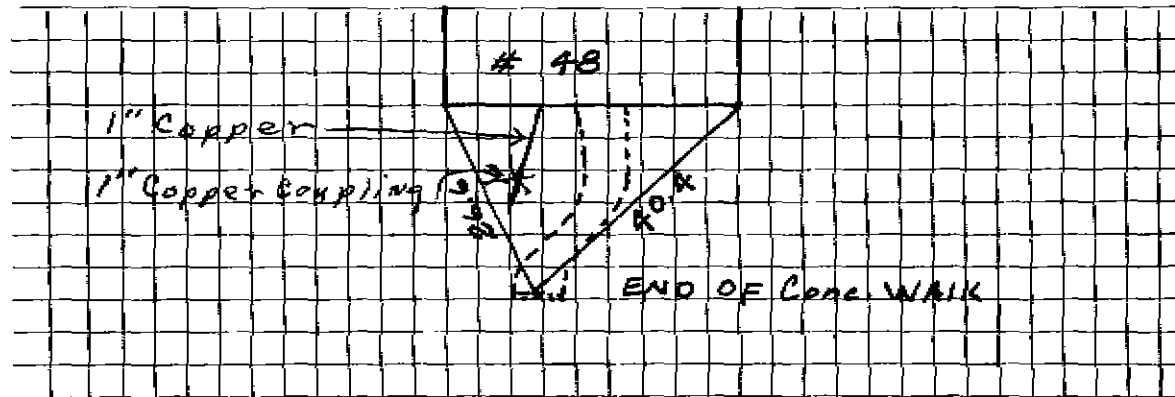

Connection made in ..... Street.

Work completed .....19

Remarks: