

WATER SERVICE RECORD

Name Daniel O'Connor

Service No. 81

Address 49 Cedar Street

1994 #7179

Location Lexington

~~Repair - Renewal - New Service~~

Com. 6-16-52


Date	Material	Amount	Total	Date	Amount
5/8/52	Labor	4 84		5-8-52 Deposited	30 00
	10% overhead	48	5 32	6-16-52 Re-vented	(2 62
	30' - 3/4" copper tubing@.3439-10	31		NON CHARGE	27 38
	1 - 3/4" C x 1/2 I.W.H. stop&waste	4 00		5/8/52 Labor	20 00
	1 hr. Littlefield shovel	7 00		10' - 3/4" copper tubing@.3439	3 43
	1 hr. trucking	75		1 - 3/4" C. adapter	1 95
			27 38	1 - 3/4" ex3/4"C.curb-cock	4 67
				1 box and rod	4 52
				1-1/8 offset tail piece	50
				1-1/8 straight tail piece	50
				1 hr. Littlefield shovel	7 00
				1 hr. trucking	75
					<u>43 32</u>

DATE _____

TOWN OF LEXINGTON — BOARD OF PUBLIC WORKS

WATER DIVISION

Sketch of Service Here

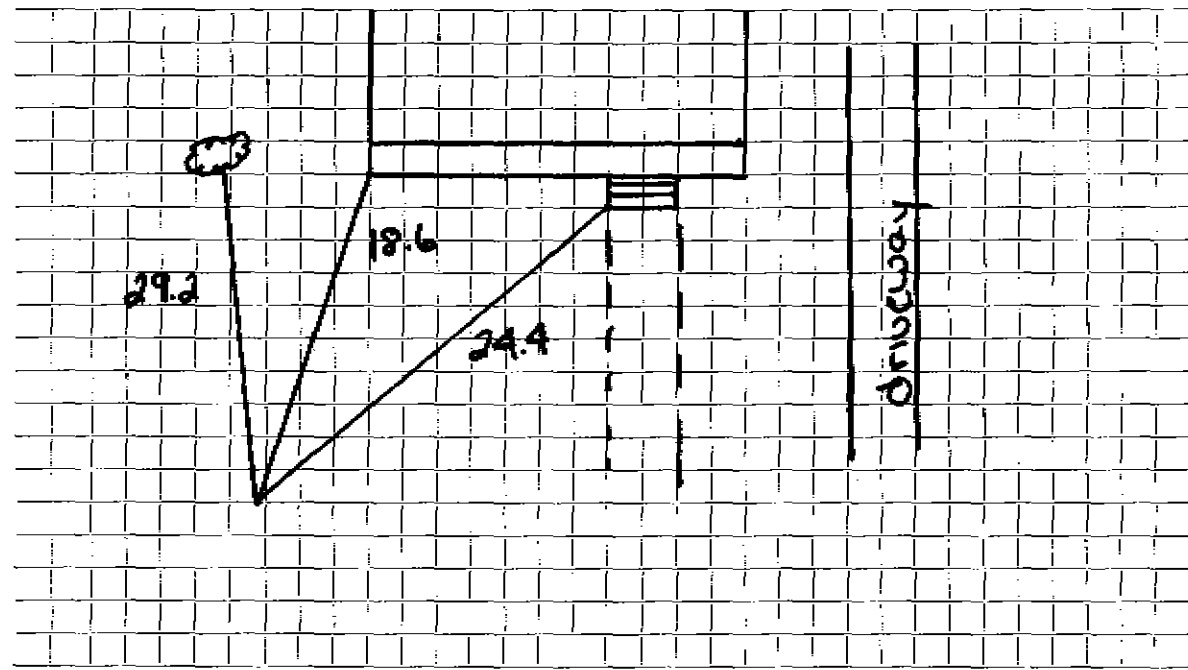

Connection made in Street. Work completed

Remarks:
.....
.....