

Name Jesse Curra

Service No. ~~#10~~ 505

Address ~~24 Cedar Street~~

4572

Location 56 Cedar Street

0 1 1 1 1 1 0

Kind of Pipe

Size

Size of Main

~~Repair~~ ~~Renewal~~ - New Service

Location

Date 1937	Material	Amount	Total	Date	Amount
Mar. 10	2 hrs. @ 60¢	1 20	1 20	March 11 1937	31 00
<i>Corr 4-20-37</i>	53' 3/4" Cop. Tub. @ 22¢		11 66	Deposited	
	1 3/4" S. & W.		2 50		
	2 hrs. Trucking @ 75¢		1 50		
			<u>16 86</u>		
Say:	53' @ 50¢		26 50		
	Trench Repairs		4 50		
			<u>31 00</u>		
	Labor				

Hadley Press, Inc., Lexington

DATE March 11, 1937

TOWN OF LEXINGTON—BOARD OF PUBLIC WORKS
WATER DIVISION

The undersigned applies for a supply of water at No. 56 Cedar Street St. and hereby agrees to comply with the rules and regulations as now, or at any future time, established by the Board of Selectmen.

Am't. of Estimate \$ 31.00

Owner Jesse Curra


Am't. Paid \$ _____

Address 24 Cedar Street

Builder _____

Lexington, Massachusetts

Sketch of Service Here

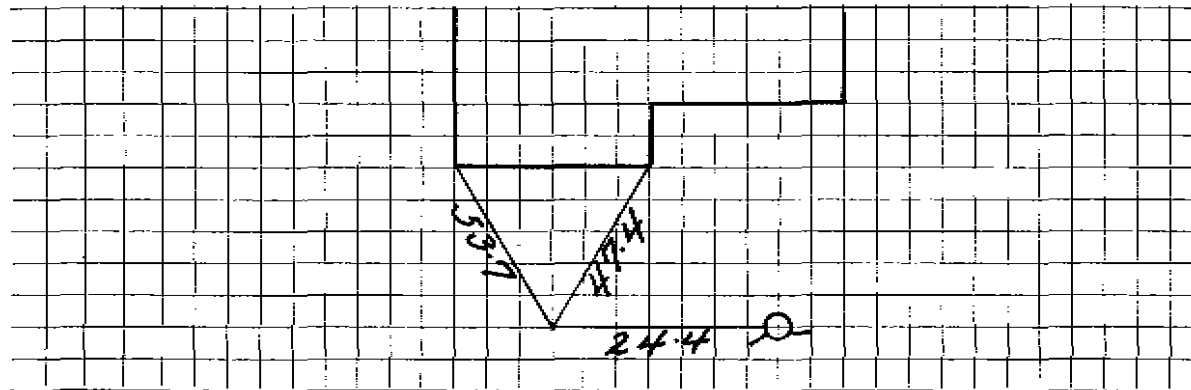

Connection made in _____ Street.

Work completed _____ 19

Remarks: