

Name Claude A. Clarke

Service No.

142  
#5680

Address 75 Cedar Street

Location 75 Cedar Street

Kind of Pipe

Size

Size of Main

~~Repair - Renewal~~ - New Service

Com. 9-19-49

Location

Date	Material	Amount	Total	Date	Amount
Jul. 30, '49	Labor	7 35	7 35	July 20, '49	195 00
	10% Overhead		74	Sept 21, '49	8 55
	43' - 3/4" Copper Tubing @.24		10 32		26 45
	1 - 3/4" C x 1/2" I.W.H. S&W		3 29	Jul. 25, '49	10 00
	Trucking 1 hr.		75	12' - 3/4" Copper Tubing @.24	2 88
	Patching 4 x 3		4 00	1 - 3/4" C Corp-cock	3 15
			26 45	1 - 3/4" C x 3/4" C Curb-cock	3 85
				1 - Box & Rod	3 95
				1 - 1/2" Straight Tail Piece	37
				1 - 1/2" Offset Tail Piece	37
				Trucking 1 hr.	75
	Labor				25 32

*Deposited*  
*Refunded*  
Non-Charge

DATE \_\_\_\_\_

TOWN OF LEXINGTON - BOARD OF PUBLIC WORKS

**WATER DIVISION**

The undersigned applies for a supply of water at No..... St. and hereby agrees to comply with the rules and regulations as now, or at any future time, established by the Board of Selectmen.

Am't of Estimate \$.....


Owner .....

Am't Paid \$.....

Address .....

Builder .....

Sketch of Service Here

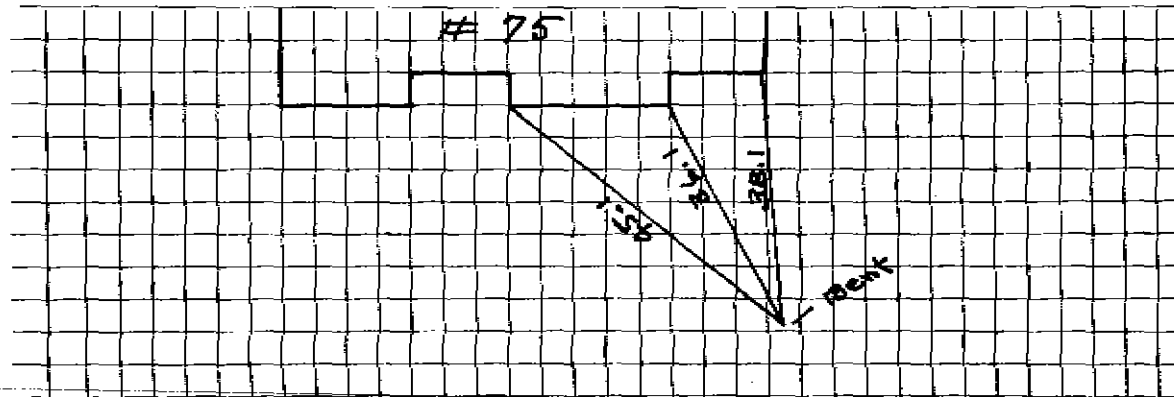

Connection made in ..... Street.

Work completed .....19

Remarks: