




DATE 10 SEPTEMBER 1995

TOWN OF LEXINGTON — BOARD OF PUBLIC WORKS

WATER DIVISION

Sketch of Service Here

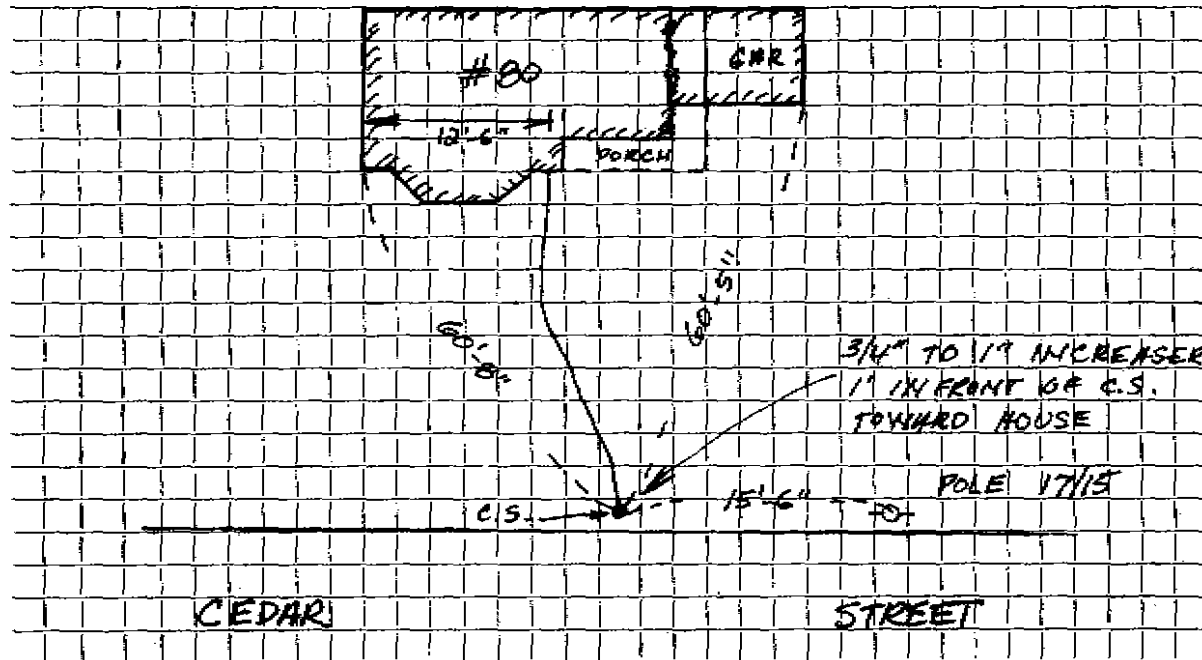

Connection made in CE DAR STREET Street.

Work completed J.M. MCLAUGHLIN, INC.

Remarks: .....