

WATER SERVICE RECORD

Name Anthony Sanseverino

Service No. 175

Address 81 Cedar Street

Location Lexington Mass.

~~Repair/Extension~~ New Service


Cam 10/1/51

Date	Material	Amount	Total	Date	Amount
8-8-51	Labor	2 98	2 98	7-31-51	Deposited 20 00
	10% Overhead		30	11-6-51	Paid 1 07
	40'-3/4" Copper Tubing @.326		13 04		21 07
	1-3/4"cx 3/4" I.W.H. S&W		4 00		No Charge
	1 Hr. Trucking		75	7-23-51	Labor 2 76
			21 07	18'-3/4" Copper Tubing @.326	5 86
				1-3/4" C Corp-Cock	4 33
				1-3/4" Cx 3/4" Curb-Cock	4 67
				Box & Rod	4 68
				1-1/2 Offset Tail Piece	50
				1-1/2 Straight Tail Piece	50
				1 Hr. Littlefield Show	7 00
				1 Hr. Trucking	75
					31 05

DATE _____

TOWN OF LEXINGTON — BOARD OF PUBLIC WORKS
WATER DIVISION

Sketch of Service Here

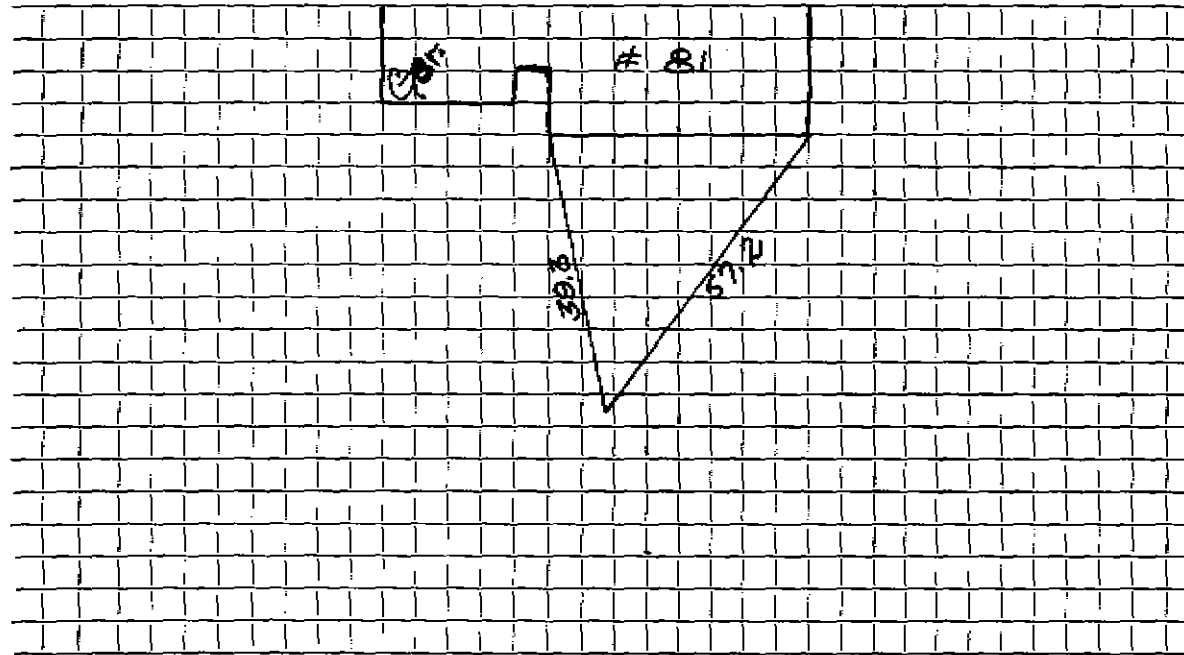

Connection made in Street. Work completed

Remarks:
.....
.....