

WATER SERVICE RECORD

#5377

Name Joseph Coletta

Service No. 303

Address 86 Cedar Street

Location Lexington, Mass.

~~Repair or Renewal~~ - New Service

Com. 12-26-50

Date	Material	Amount	Total	Date	Amount
Oct. 13, '50	Labor	2 70	2 70	Hydrant	25 00
	10% Overhead		27	Excavated	4 30
	83' - 3/4" Copper Tubing @.32	26 56		No Charge	70 65
	1 - 3/4" C x 1/2" I.W.H. S&W	3 76		Oct. 13, '50 Labor	6 05
	1 - 3/4" C x 3/4" C Union (3pts)	1 61		83' - 3/4" Copper Tubing @.32	10 56
	Littlefield Shovel 2 hrs. @7.00	14 00		1 - 3/4" C Corp-cock	3 60
	Trucking 1 hr. @.75	75		1 - 3/4" C x 3/4" C Gurb-cock	4 40
	Patching 21 x 3	21 00		1 - Box & Rod	4 44
			70 65	1 - 1/2" Offset Tail Piece	42
				1 - 1/2" Straight Tail Piece	42
				Littlefield Shovel 2 hrs. @7.00	14 00
				Trucking 1 hr. @.75	75
					44 63


DATE _____

TOWN OF LEXINGTON — BOARD OF PUBLIC WORKS

WATER DIVISION

Sketch of Service Here

W.S. Exp # 86

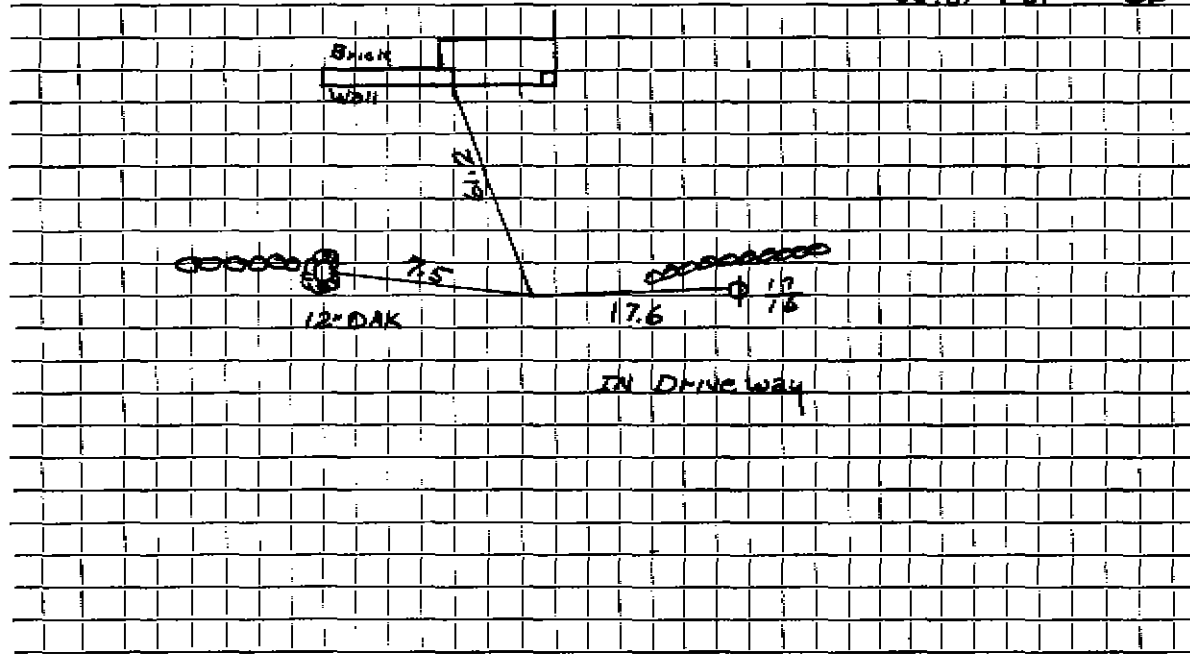

Connection made in Street. Work completed

Remarks:
.....
.....