

Name Leonard Jellis Jr.

Service No. 226

Address 87 Cedar Street

#3074

Lexington, Mass.

Locatic 87 Cedar Street

Kind of Pipe

Size

Size of Main

~~Repair~~ ~~Renewal~~ ~~XXXXXX~~ ~~XXXXXX~~ New Service

Com. 11-6-50

Location

Date	Material	Amount	Total	Date	Location	Amount
Sept. 6, '50	Labor	1 25	1 25	Aug 14 '52	<i>He worked Paid</i>	20 00
	10% Overhead		13	Feb 12 '51		<u>3 55</u>
	55' - 3/4" Copper Tubing @.275	3.275	15 23		No Charge	23 63
	1 - 3/4" C x 1/2" I.W.E. S&W		3 29	Sept. 6, '50	Labor	1 50
	Trucking 1 hr. @.75		75	9' - 3/4" Copper Tubing @.275		2 48
	Patching 3 x 3		3 00	1 - 3/4" C Corp-cock		3 15
			<u>23 55</u>	1 - 3/4" C x 3/4" Curb-cock		3 85
				1 - Box & Rod		3 35
				1 - 1/2" Offset Tail Piece		42
				1 - 1/2" Straight Tail Piece		42
				Littlefield Shovel 2 hrs. @7.00		14 00
				Trucking 1 hr. @.75		75
	Labor					<u>29 92</u>

Hudley Press, Inc., Lexington

DATE _____

TOWN OF LEXINGTON—BOARD OF PUBLIC WORKS

WATER DIVISION

The undersigned applies for a supply of water at No. _____ St. and hereby agrees to comply with the rules and regulations as now, or at any future time, established by the Board of Selectmen.

Am't. of Estimate \$ _____


Owner _____

Am't. Paid \$ _____

Address _____

Builder _____

Sketch of Service Here

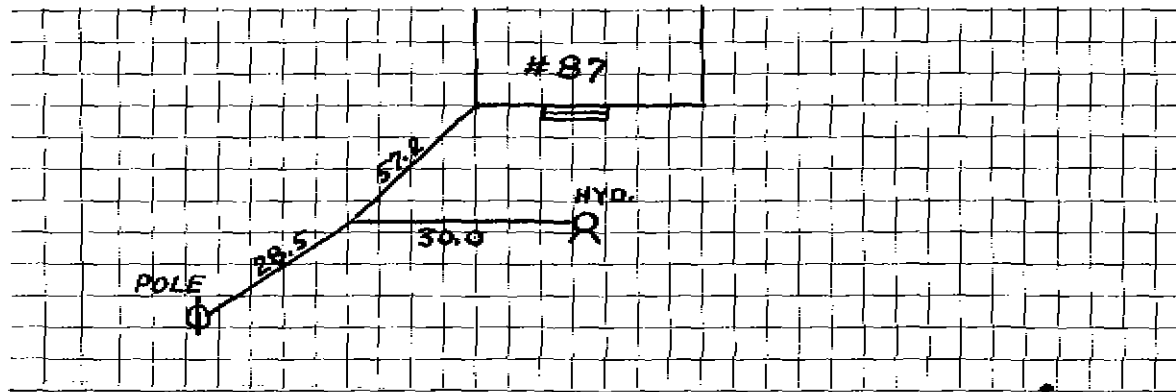

Connection made in _____ Street.

Work completed _____ 19

Remarks: