

WATER SERVICE RECORD

#6157

Name Joseph Hurley

Service No. 284 #6190

Address 9-11 Cedar Street

(11) - 6230

Location

~~Repair~~ - Renewal - ~~New Service~~

Comm. 3-3-58


Date	Material	Amount	Total	Date	Amount
12/12/57	Labor	42 60		12-9-57	Deposit \$ 75 00
	10% overhead	4 26		3-3-58	Refund 14 63
			46 86		\$ 60 37
	15' 3/4" copper tubing @ .37	5 55			
	1 3/4" Cx 1/2 IWH stop & waste	4 96			NON CHARGE
	1 hr. Hough @ 3.00	3 00			labor 28 40
			60 37		
				10' 3/4 copper tubing @ .37	3 70
				1 3/4" C corp cock	4 64
				1 3/4" curb cock	5 94
				1 3/4" adapter	1 95
				1 1/2 offset tail piece	50
				1 1/2 straight tail piece	50
				1 hr trucking @ .75	75
				2 hrs. compressor @ 3.00	6 00
				5 x 2 patch	5 00
					<u>57 38</u>

DATE

TOWN OF LEXINGTON — BOARD OF PUBLIC WORKS

WATER DIVISION

Sketch of Service Here

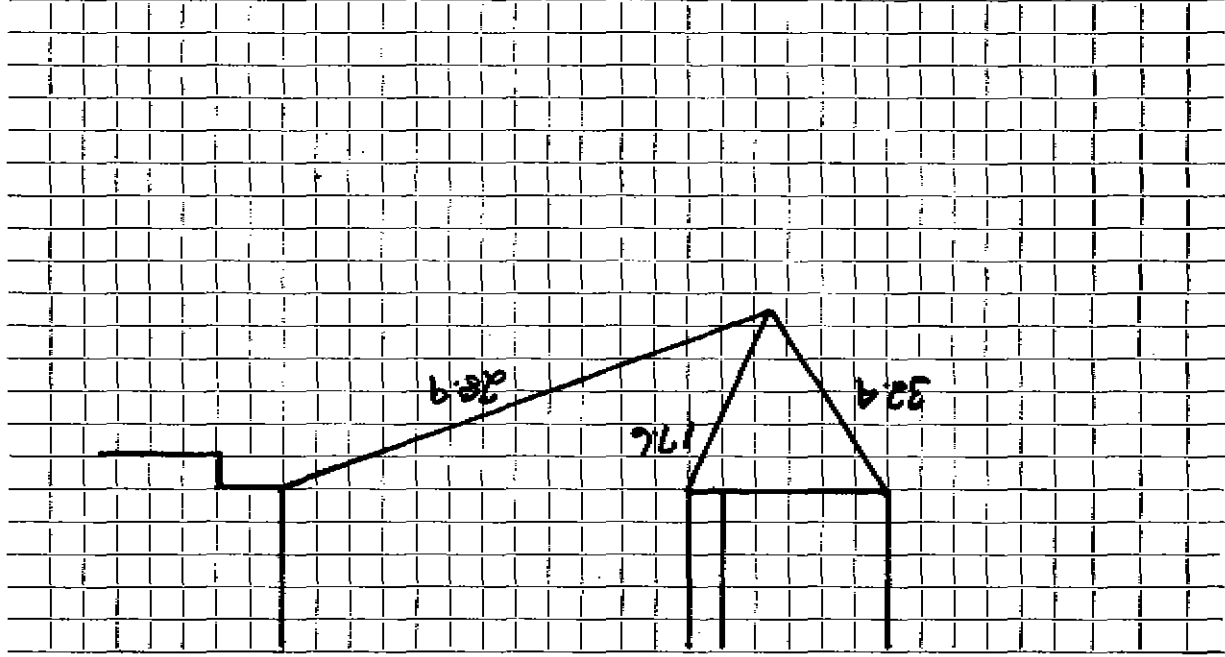

Work completed

Street

Connection made in

Remarks: