


TOWN OF LEXINGTON - BOARD OF PUBLIC WORKS  
WATER DIVISION

Date: 8/2021

SKETCH OF SERVICE HERE

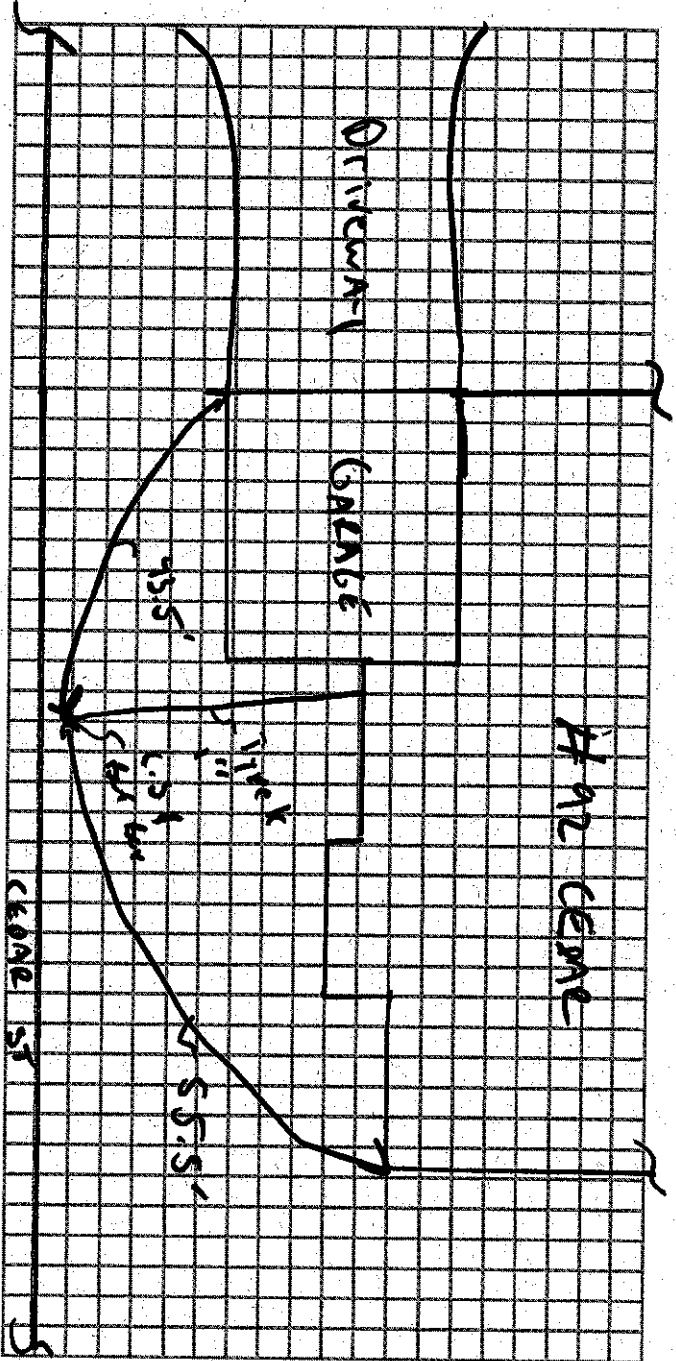

Connection made in: CEPAC

Street:

Work completed:

Remarks:

Address 92 CEDAR ST

Location

Repair Renewal New Service

Date	Material	Amount	Total	Date		A
8/2021	C.S & Bnt Box					
	1" Type K Copper					

WATER SERVICE RECORD

3718  
3717  
68

Name Dianne Estates

Service No.

68

Address 92 Cedar Street

Location

~~REPAIR~~ ~~Renewal~~ ~~NEW SERVICE~~

*Comm 7-5-68*

Date	Material	Amount	Total	Date	Amount
5-18-60	Labor	2 05		5-18-60	25 00
	10% O.H.	21	2 26	7-14-60	6 54
	50' 3/4" Copper tubing @42		21 00		31 54
	1 3/4" Cx 1/2 I.W.E. Stop&Waste		6 17		<u>NON CHARGE</u>
	1 3/4" C3 part union		2 41		Labor
			31 84		1 69
				25' 3/4" Copper tubing @42	9 66
				1 3/4" C Corp Cock	4 91
				1 3/4" C Curb Cock	6 28
				1 Box & Rod	5 00
				1 1/2 Straight tailpiece	50
				1 1/2 Offset tailpiece	50
					<del>26 35</del>
					28 54


*B.*

DATE \_\_\_\_\_

TOWN OF LEXINGTON — BOARD OF PUBLIC WORKS

**WATER DIVISION**

Sketch of Service Here

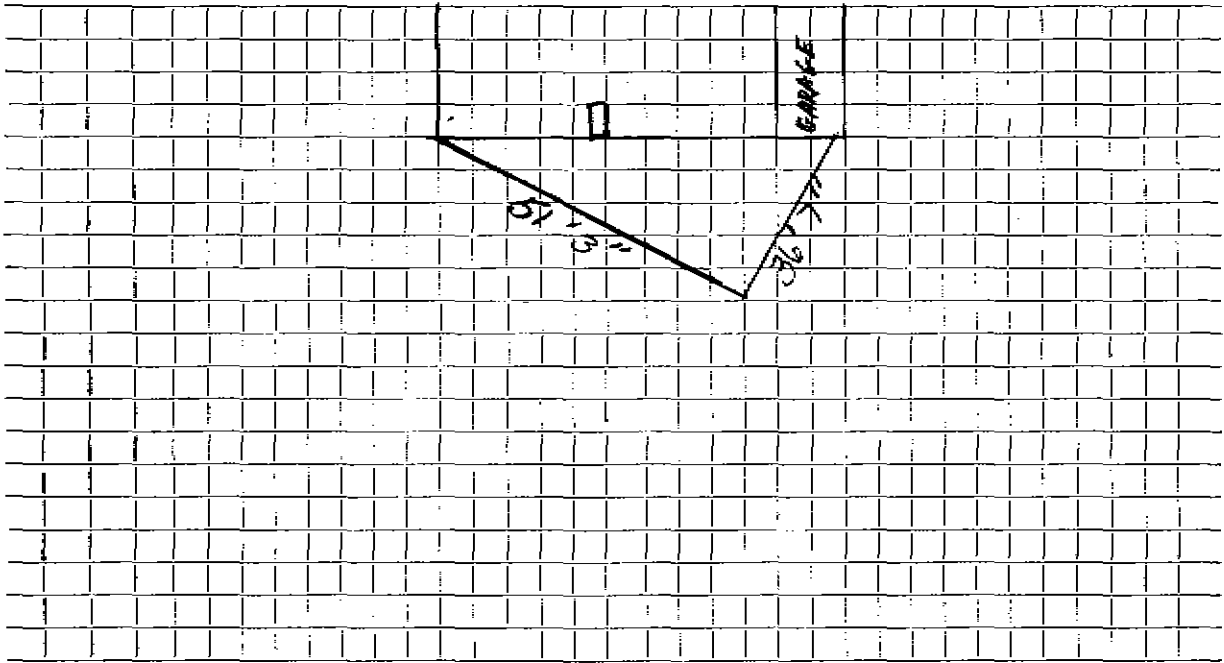

Connection made in ..... Street. Work completed .....

Remarks: .....  
.....  
.....