

Name Ronald White

Service No. # 4407
115

Address 97 Cedar Street

Location 97 Cedar Street

Kind of Pipe

Size

Size of Main

~~Repair~~ ~~Renewal~~ New Service

Com. 8-15-49

Location

Date	Material	Amount	Total	Date	Amount
July 9, '49	Labor	2 35	2 35	June 25, '49	25 00
	10% Overhead		24	Aug 23 '49	
	39' - 3/4" Copper Tubing @.24	9 36	9 36	<i>Deposited</i>	
	1 - 3/4" C x 1/2" I.W.H. S&W	3 29	3 29	<i>Refunded</i>	
	1 - 3/4" C x 3/4" C Union	1 39	1 39	Non-Charge	
	Trucking 1 hr.	75	75	July 9, '49	3 57
	Patching 5 x 3	5 00	5 00	13' - 3/4" Copper Tubing @.24	3 12
			22 38	1 - 3/4" C Corp-cock	3 15
				1 - 3/4" C x 3/4" C Curb-cock	3 85
				1 - Box & Rod	3 95
				1 - 1/2" Offset Tail Piece	37
				1 - 1/2" Straight Tail Piece	37
				Littlefield Shovel 1 1/2 hrs. @7.00	10 50
				Trucking 1 hr.	75
	Labor				29 63

DATE _____

TOWN OF LEXINGTON - BOARD OF PUBLIC WORKS
WATER DIVISION

The undersigned applies for a supply of water at No. St. and hereby agrees to comply with the rules and regulations as now, or at any future time, established by the Board of Selectmen.

Am't of Estimate \$.....

Owner


Am't Paid \$.....

Address

Builder

.....

Sketch of Service Here

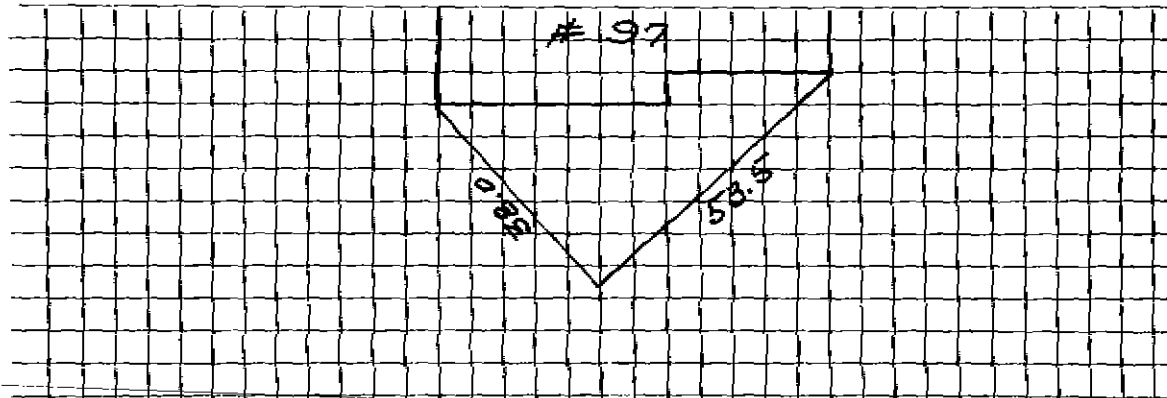

Connection made in Street.

Work completed19

Remarks: