
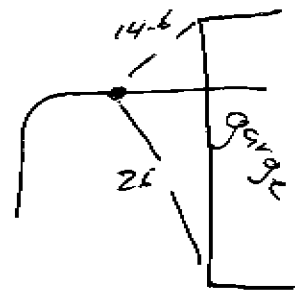


TOWN OF LEXINGTON — BOARD OF PUBLIC WORKS

WATER DIVISION

Sketch of Service Here

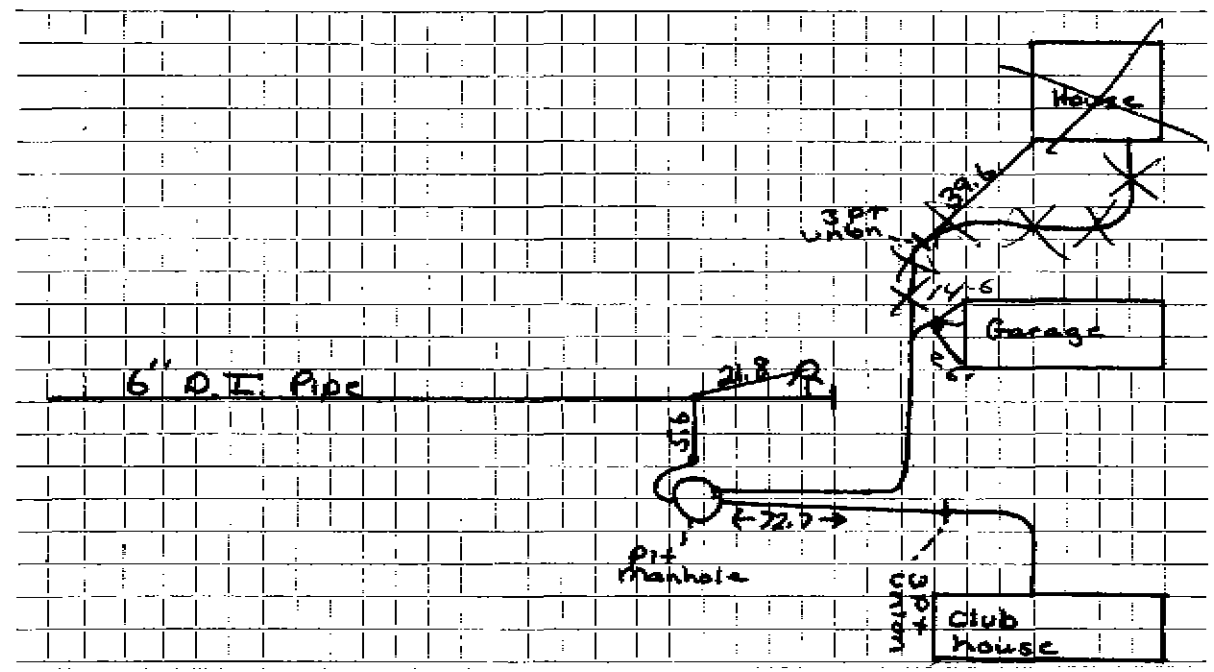


Connection made in Street. Work completed

Remarks: 1" Copper to Pit, 1" Copper to Club house, 3/4" Copper to Small house.
1996 service install in garage 3/4" curb 2 1/2 box

DATE 2-28-92

TOWN OF LEXINGTON — BOARD OF PUBLIC WORKS
WATER DIVISION

Sketch of Service Here

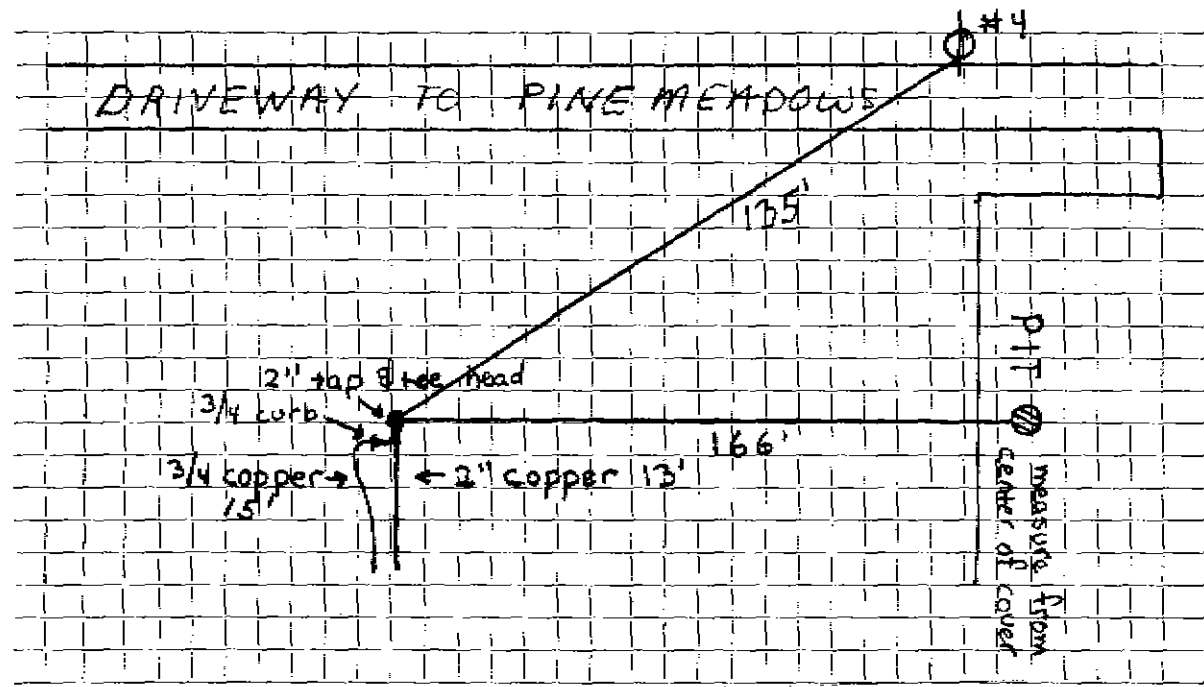

Connection made in Street. Work completed

Remarks:
.....
.....