




Date: 6/8/2023

TOWN OF LEXINGTON - BOARD OF PUBLIC WORKS

WATER ~~SEWER~~ DIVISION

SKETCH OF SERVICE HERE

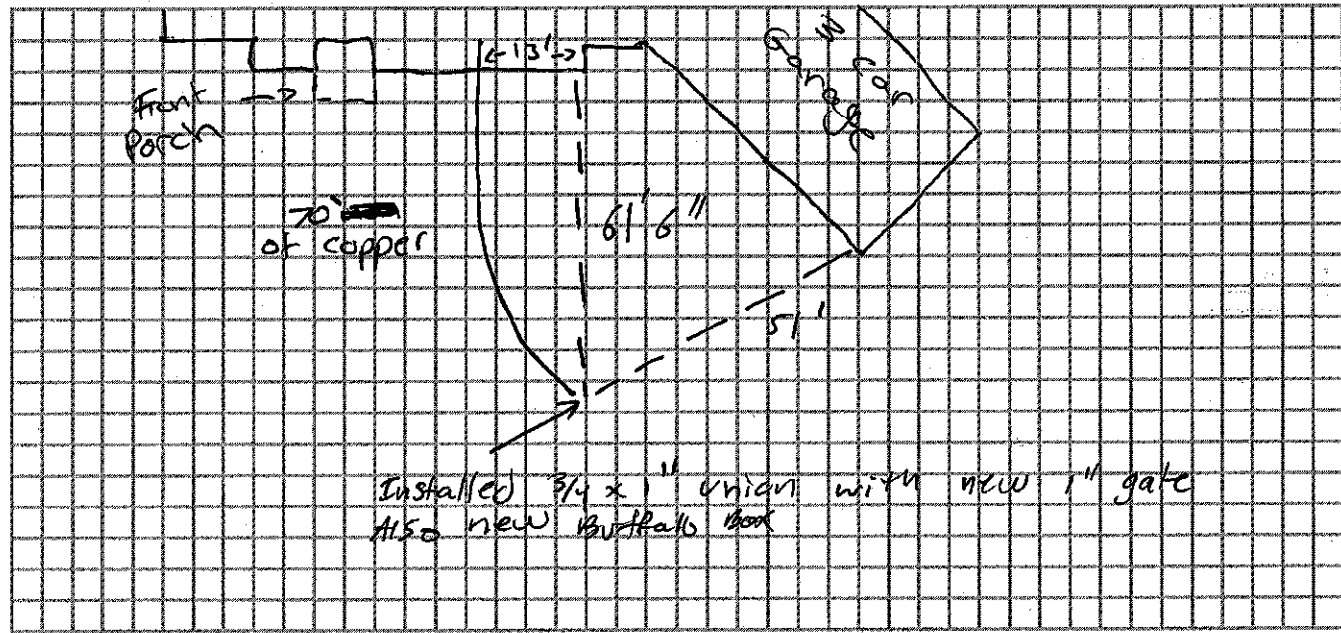

Connection made in: 5 cedarwood terrace Street.

Work completed:

Remarks:

Installed by J.M. McLaughlin inc.