

Name Stanley Phalen

Service No. 187

Address 6 Cedarwood Terrace

Lexington, Mass.

Location 6 Cedarwood Terrace

Kind of Pipe

Size

Size of Main

~~Renewal~~ New Service

Com. 11-8-49

Location

Date	Material	Amount	Total	Date	Amount
Sept. 23, '49	Labor	1 35	1 35	Sept 14 '49	20 00
	10% Overhead		14	Nov 16 '49	5 93
	60' - 3/4" Copper Tubing @ .24	14 40	14 40		No Charge
	1 - 3/4" C x 1/2" I.W.H. S&W	3 29	3 29	Sept. 23, '49	Labor
	Trucking 1 hr. @ .75	75	75		9' - 3/4" Copper Tubing @ .24
	Patching 6 x 3	6 00	6 00		1 - 3/4" C Corp-cock
			25 93		1 - 3/4" C x 3/4" C Curb-cock
					1 - Box & Rod
					1 - 1/2" Offset Tail Piece
					1 - 1/2" Straight Tail Piece
					Littlefield Shovel 2 1/2 hrs. @ 7.00
					Trucking 1 hr. @ .75
	Labor				46 42

Bill sent 11-10-49

DATE \_\_\_\_\_

### TOWN OF LEXINGTON - BOARD OF PUBLIC WORKS

## WATER DIVISION

The undersigned applies for a supply of water at No..... St. and hereby agrees to comply with the rules and regulations as now, or at any future time, established by the Board of Selectmen.

Am't of Estimate \$.....


Owner .....

Am't Paid \$.....

Address .....

Builder .....

Sketch of Service Here

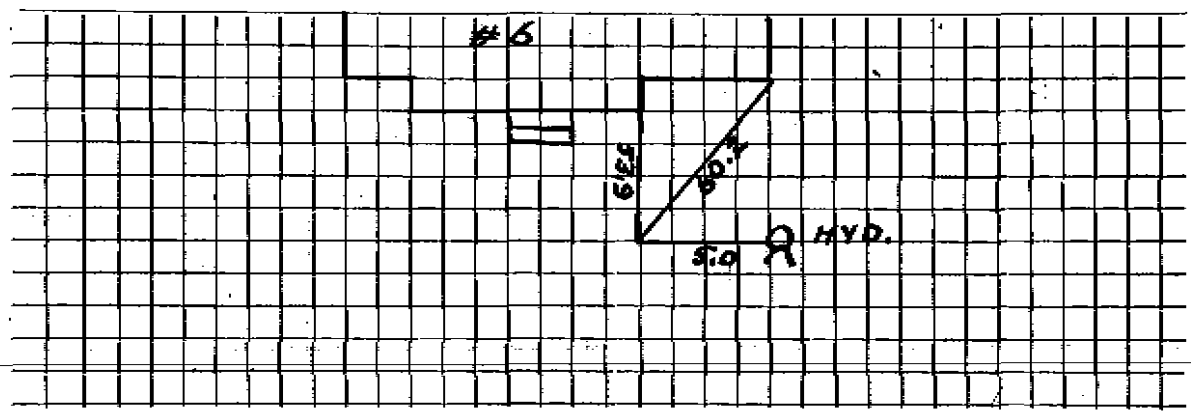

Connection made in ..... Street.

Work completed .....19

Remarks: