

WATER SERVICE RECORD

Name Theodore Fleming

Service No. 175
208

Address 10 Center Street

Location


~~Repair~~ - Renewal - ~~New Service~~

Date	Material	Amount	Total	Date	Curb to Main	Amount
7/18/56	Labor	11 80			NON CHARGE	
	10% overhead	1 18	12 98		Labor	3 80
	28' 3/4" Coppertubing @.4850		13 58	10'	3/4" Coppertubing @.4850	4 85
	1 3/4" Cx 1/2 IWH Stop & Waste		4 96	1	3/4" Copper Corp	4 64
	1 hr Littlefield @ 8.50		8 50	1	3/4" Curb Cock	5 94
	1 hr trucking @ .75		75	1	1/2" Straight tail piece	50
			40 77	1	1/2" Offset tail piece	50
						25 89
				6-26-56		\$
				7-12-56	Deposits	50 00
				10-2-56	Refund	9 23
						40 77

DATE _____

TOWN OF LEXINGTON — BOARD OF PUBLIC WORKS
WATER DIVISION

Sketch of Service Here

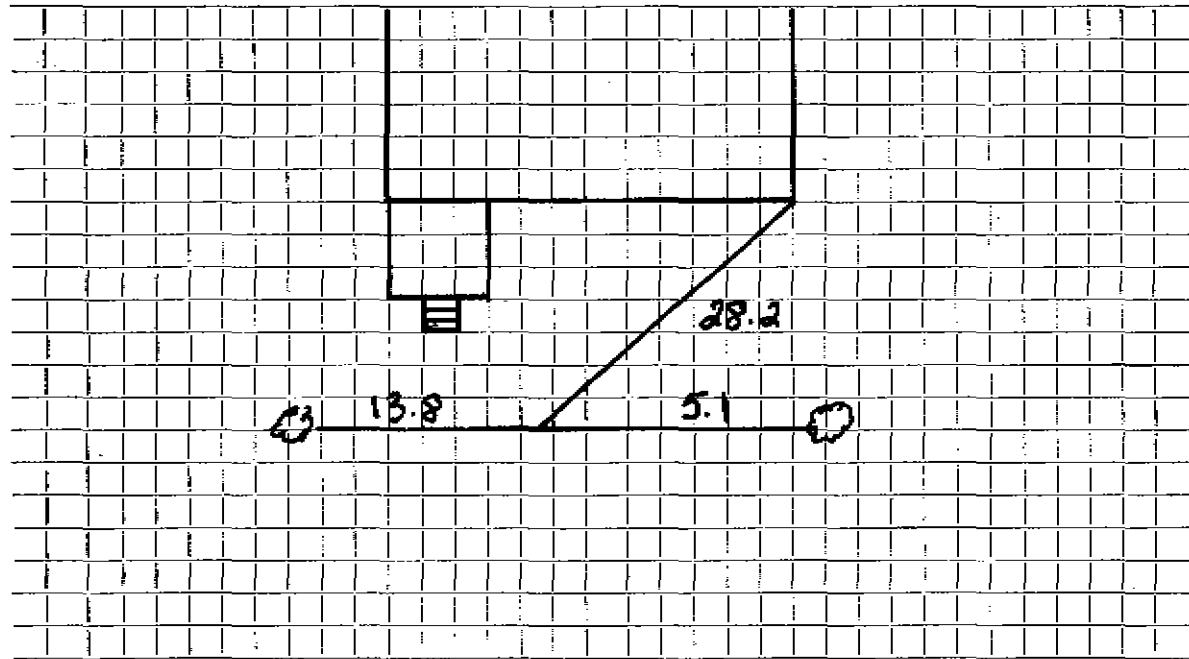

Connection made in Street. Work completed

Remarks:
.....
.....