

WATER SERVICE RECORD

Name Donna Realy True

Service No. 59

Address 29 Center Street

Location

Repair: ~~Renewal~~ New Service # W.O. 7147 Valeri #1509

DEC 20 1969


Date	Material	Amount	Total	Date	Amount
12/1/69	Labor	11 22		11-25-69	100 08
	10% O.H.	1 12	12 34	12-23-69	48 03
21'	3/4" Copper pipe .79		16 59		51 97
	3/4" Corporation		9 57		
	3/4" Curb Stop		8 37		
	Box & Rod		5 10		
			51 97		
12-3-69	36' 3/4" Copper tubing				

DATE _____

TOWN OF LEXINGTON - BOARD OF PUBLIC WORKS

WATER DIVISION

Sketch of Service Here

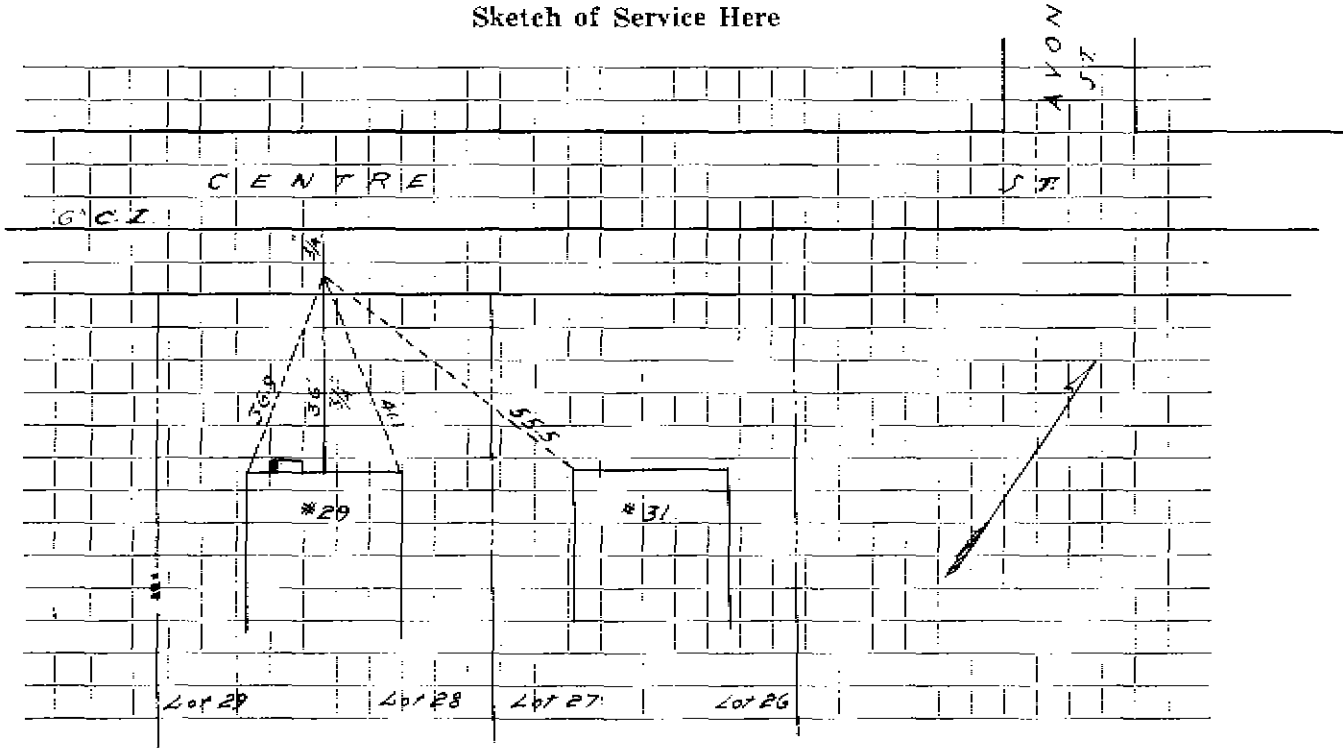

Connection made in Street. Work completed

Remarks :
.....
.....