

Donna Realty Trust

WATER SERVICE RECORD

Service No. 60

Name Donna Realty Trust

Address 31 Center Street

Location

~~REPAIR WORK~~ New Service # W.O. 7149 Valeri #1510

DEC 31 1969


Date	Material	Amount	Total	Date	Amount
12/1/69	Labor		11 22	11-25-69	100 00
10%	O.H.		1 12	12-22-69	47 24
22'	3/4" Copper pipe .79		17 38		52 76
	3/4" Corporation		9 57		
	3/4" Curb Stop		8 37		
	Box & Rod		5 10		
			<u>52 76</u>		
12-3-69	36' 3/4" Copper tubing				

DATE _____

TOWN OF LEXINGTON BOARD OF PUBLIC WORKS

WATER DIVISION

Sketch of Service Here

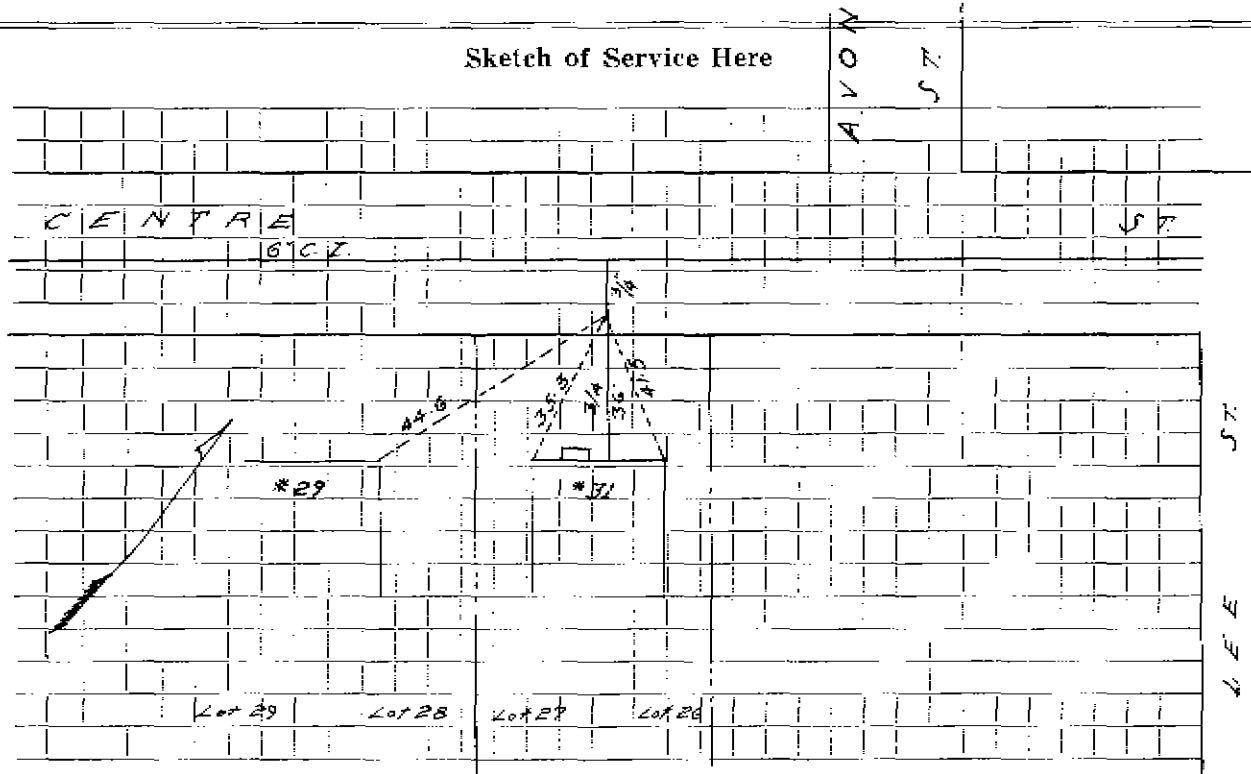

Connection made in Street. Work completed

Remarks:
.....
.....