

WATER SERVICE RECORD

Name Kenneth Mills

Service No. 130

Address 33 Center Street

Location

~~REPAIR~~—Renewal—~~REPAIR~~


Comm. 11-24-58

Date	Material	Amount	Total	Date	Amount
8/11/58	Labor	1.85		7-3-58	50.00
	10% O.H.	.19	2.04	11-24-58	19.86
52'	1" Copper Tubing @ .37		19.24		30.14
1	1" C x 1" IWH Stop & Waste		5.84		
					OUTSIDE
1	1" C 3 part Union		2.27	8/11/58	Labor \$1.77
1	hr. Trucking @ .75		.75	21'	1" Copper Tubing @ .37 7.77
			\$30.14	1	1" C Corp Cock 4.64
				1	1" C Curb Cock 6.03
				1	Box & Rod 5.00
					\$25.21

DATE _____

TOWN OF LEXINGTON — BOARD OF PUBLIC WORKS
WATER DIVISION

Sketch of Service Here

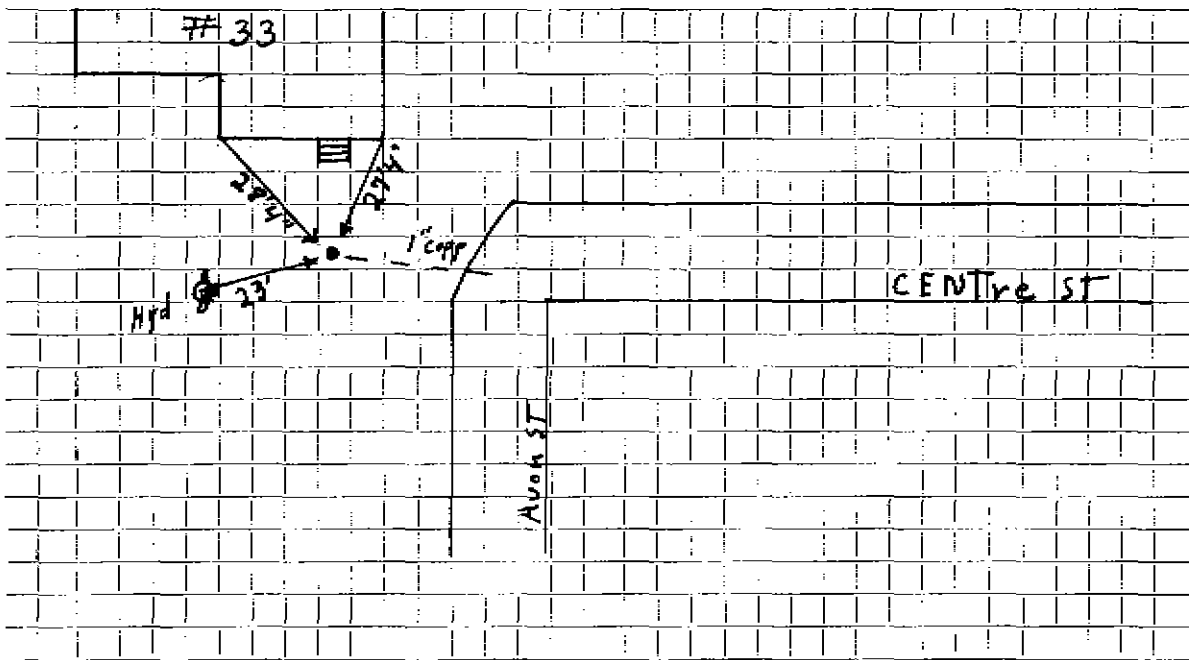

Connection made in Street. Work completed

Remarks:

.....

.....