

# 1044

### WATER SERVICE RECORD

<b>Name</b>		<b>Service No.</b>	
<b>Address</b>	5 Centre St.		
<b>Location</b>	Lexington		
<b>Repair</b> <del>Repair</del>	<b>Renewal</b> <del>Renewal</del>	<b>New Service</b>	<del>XXXXXX</del>


Date	Material	Amount	Total	Date	Amount
				NON CHARGE	
				2/16/53 Labor	19 81
				30'-3/4" Copper Tubing @.34	10 20
				1-3/4" C. Adapter	2 95
				1-3/4" C x 3/4" C. Curb-cock	1 67
				3 Hrs. Littlefield Shovel @7.00	21 00
				1 Hr. Trueling	75
				Patching 18 x 3	18 00
					76 38

DATE \_\_\_\_\_

TOWN OF LEXINGTON — BOARD OF PUBLIC WORKS

WATER DIVISION

Sketch of Service Here

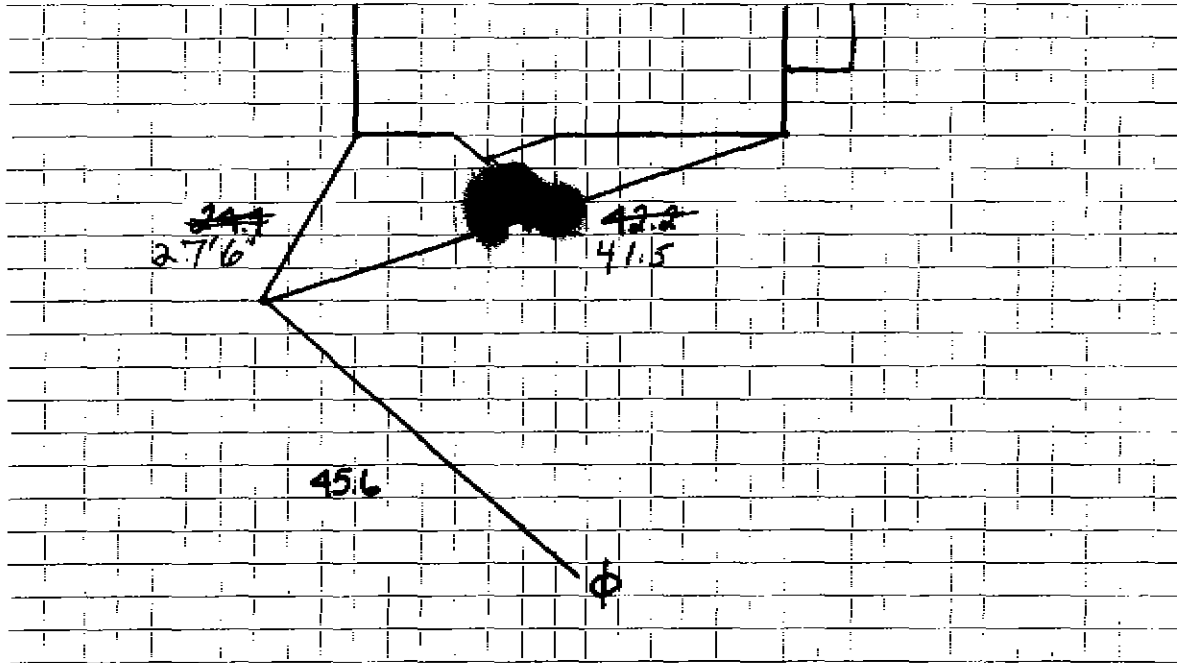

Connection made in ..... Street. Work completed .....

Remarks: .....

.....

.....