

WATER SERVICE RECORD

Name Custom Colonials Inc.

Service No. 94

Address 11 Chadbourne Rd.

Location Lexington

~~REPAIR & EXTENSION~~ - New Service

WO# 8178

Comm. 10-28-63


Date	Material	Amount	Total	Date	Amount	
9-5-63	Labor	2.77		9-5-63	Deposit	50.00
	10% O.H.	.28	3.05	10-28-63	Paid by W/C# 41	15.03
	120' 3/4" Copper tubing @.42		50.40		NON CHARGE	65.03
	1 3/4" CX 1/2 I.W.H. Stop & Waste		6.17	5/13/53	Labor	3.49
	1 3/4" C3 Part Union		2.41		20'-3/4" Copper Tubing @.34	6.80
	1 Hr. Trucking @3.00		3.00		1-3/4" C. Corp-cock	4.33
			65.03		1-3/4" C x 3/4" C. Curb-cock	4.67
					1-Box & Rod	3.90
					1 Hr. Trucking	75
						23.94
				9-5-63	1 1/2 Straight tailpiece	50
					1 1/2 Offset tailpiece	50
						24.94

DATE \_\_\_\_\_

TOWN OF LEXINGTON — BOARD OF PUBLIC WORKS

**WATER DIVISION**

Sketch of Service Here

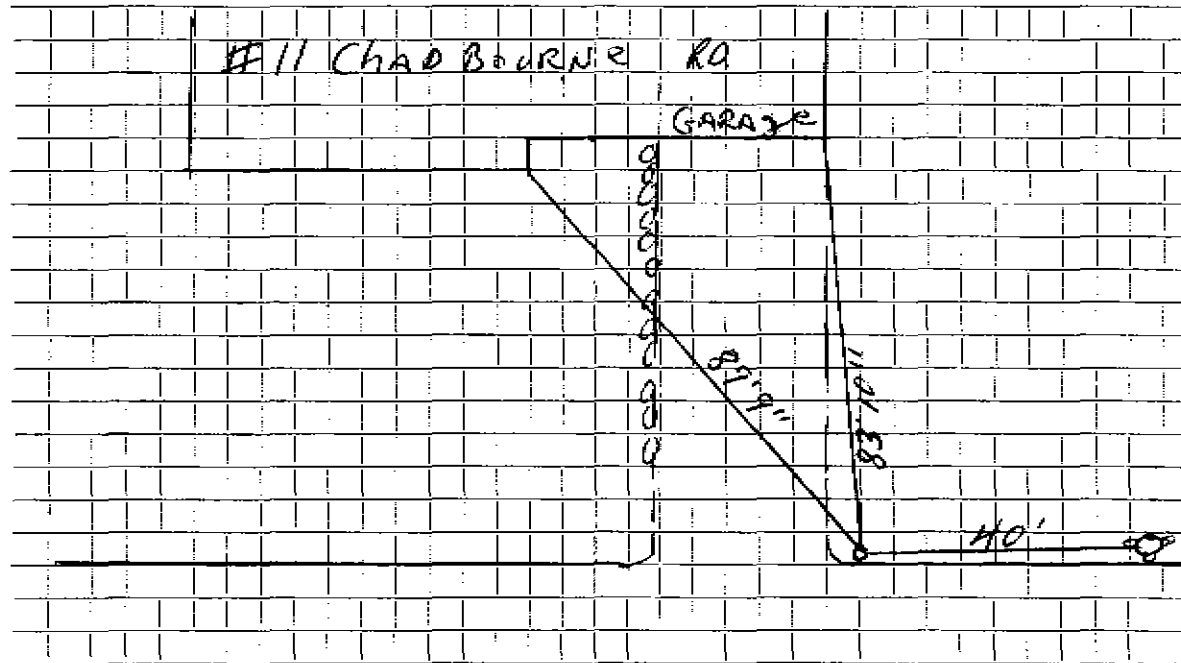

Connection made in ..... Street. Work completed .....

Remarks: .....

.....

.....