

WATER SERVICE RECORD

Name Harold Casson

Service No. 51

Address 15 Chabourne Rd.

Location Lexington

~~REPAIR~~ RENEWAL - New Service

*Comm. 4-19-61*


Date	Material	Amount	Total	Date	Amount	
4-26-61	Labor	2.32		4-25-61	Deposit	50.00
	10% O.H.	.23	2.55	4-19-61	Retard	2.29
80'	3/4" Copper Tubing @.42		33.60		NON CHARGE	47.73
1	3/4" c x 1/8 I.W.H. Stop & Waste	6.17	5/13/53	Labor	3.49	
1	3/4" C 3 part union	2.41	20'-3/4" Copper Tubing @.34		6.80	
1	Hr. Trucking @3.00	3.00	1-3/4" C. Corp-cock		4.33	
		47.70	1-3/4" C x 3/4" C. Curb-cock		4.67	
			1-Box & Rod		3.90	
			1 Hr. Trucking		75	
					23.94	
				1 1/8 Straight tailpiece	.50	
				1 1/8 Offset tailpiece	.50	
					24.94	

DATE \_\_\_\_\_

TOWN OF LEXINGTON — BOARD OF PUBLIC WORKS

WATER DIVISION

Sketch of Service Here

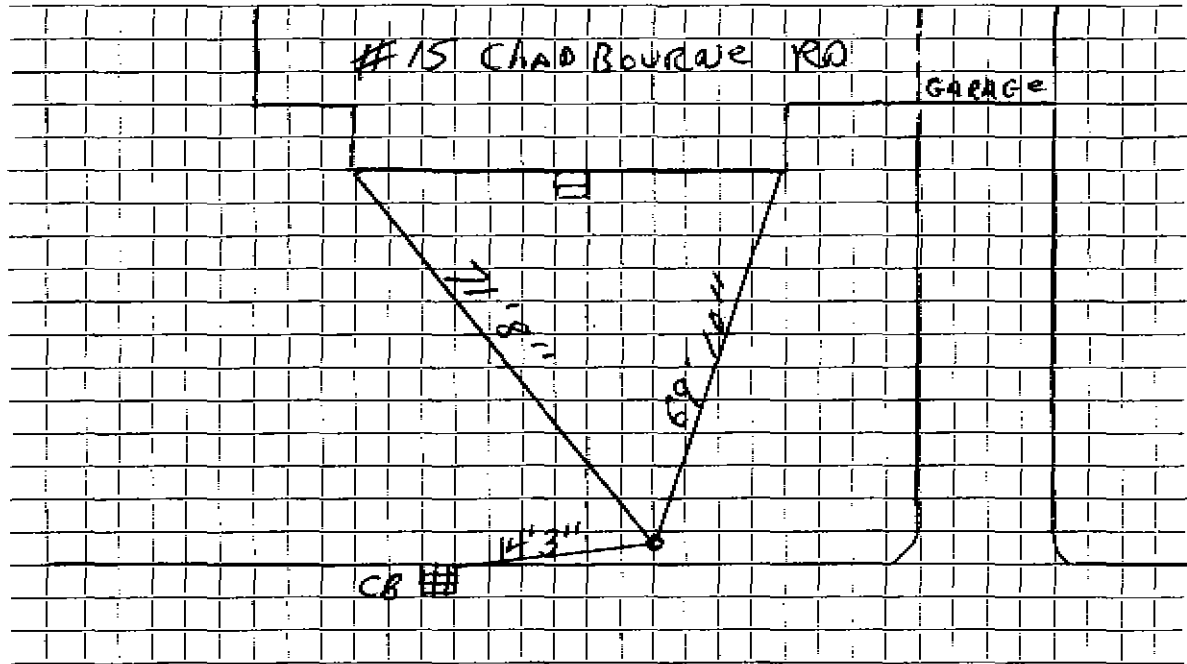

Connection made in \_\_\_\_\_ Street. Work completed \_\_\_\_\_

Remarks: \_\_\_\_\_

\_\_\_\_\_

\_\_\_\_\_