


DATE _____

TOWN OF LEXINGTON — BOARD OF PUBLIC WORKS

WATER DIVISION

Sketch of Service Here

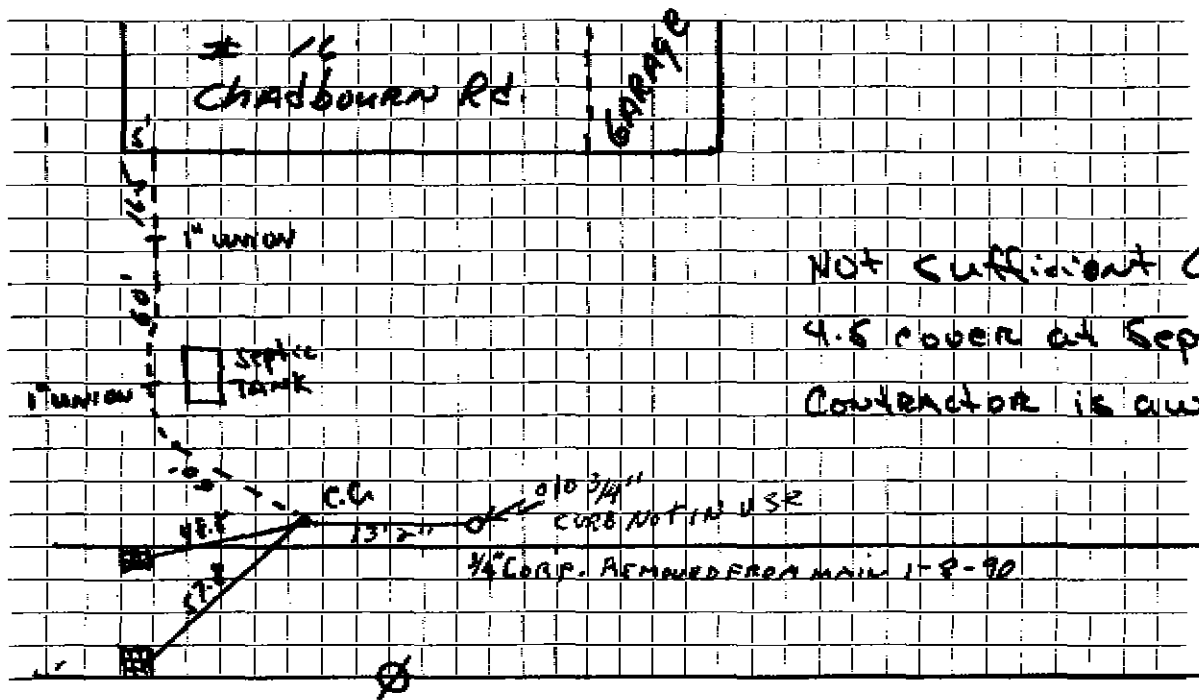

NOT SUFFICIENT COVER - 1.5'
4.5' cover at Septic Tank.
Contractor is aware

Connection made in _____ Street. Work completed _____

Remarks: _____

