




DATE 9-17-01

TOWN OF LEXINGTON — BOARD OF PUBLIC WORKS  
WATER DIVISION

Sketch of Service Here

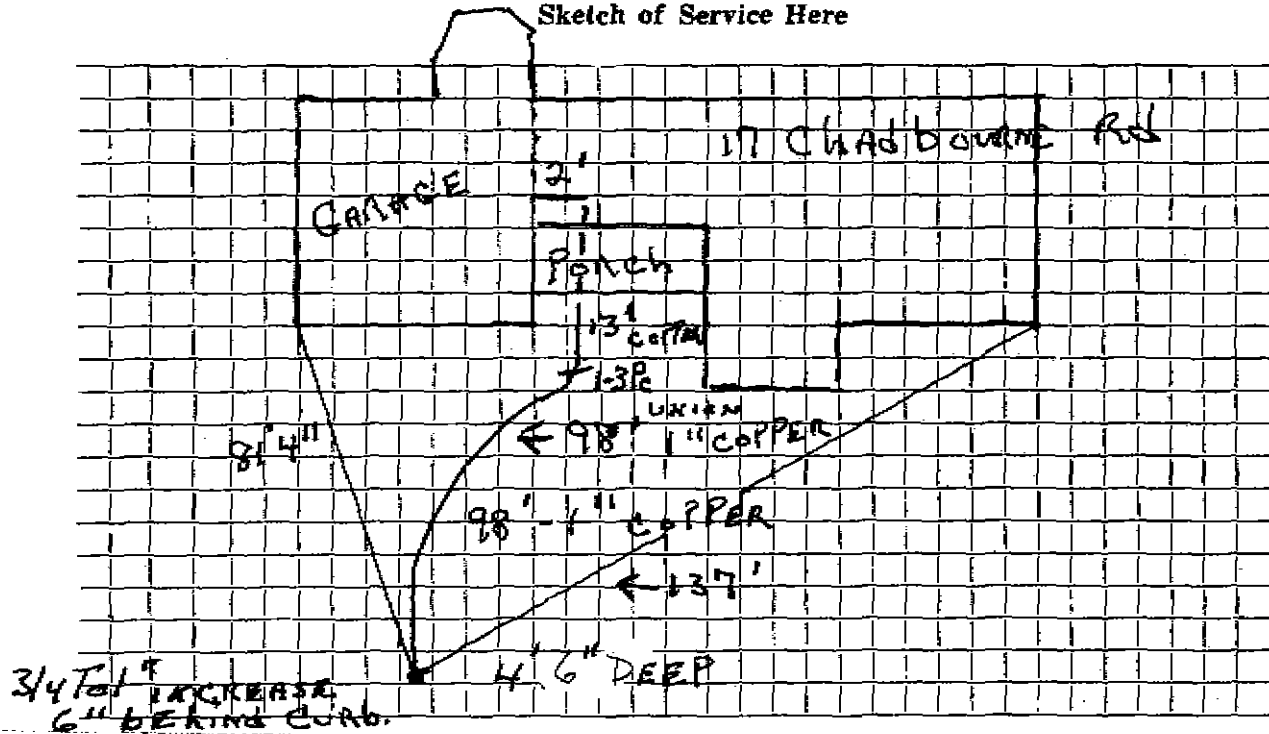

Connection made in Ch Ad Bourne Rd Street. Work completed

Remarks: J. M. McLaughlin, Installer.