

WATER SERVICE RECORD

Name Anthony Ferro  
 Address 18 Chadbourne Rd.  
 Location Lexington

Service No. 246

# 1930

~~REPAIRS TO EXISTING~~ - New Service

Comm 12-14-59


Date	Material	Amount	Total	Date	Amount
10-9-59	Labor	31 00		10-2-59	Deposit 100 00
	10% O. H.	3 10	34 10	12-14-59	Returned 14 27
69'	3/4" copper tubing @.42		28 98		NON CHARGE 85 73
1	3/4" C x 1/2 I.W.H. Stop & Waste	5 88		5/13/53	Labor 3 49
1	3/4" C 3 part Union	2 27		10'-3/4" Copper Tubing @.34	3 40
2	Hrs. Trucking @.75	1 50		1-3/4" C. Corp-cock	4 33
2	Hrs. Town Shovel @6.50	13 00		1-3/4" C x 3/4" C. Curb-cock	4 67
			85 73	1-Box & Rod	3 90
				1 Hr. Trucking	75
					20 54
				10-9-59	1 1/2 Straight Tailpiece 50
					1 1/2 Offset Tailpiece 50
					21 54

DATE \_\_\_\_\_

TOWN OF LEXINGTON — BOARD OF PUBLIC WORKS

**WATER DIVISION**

Sketch of Service Here

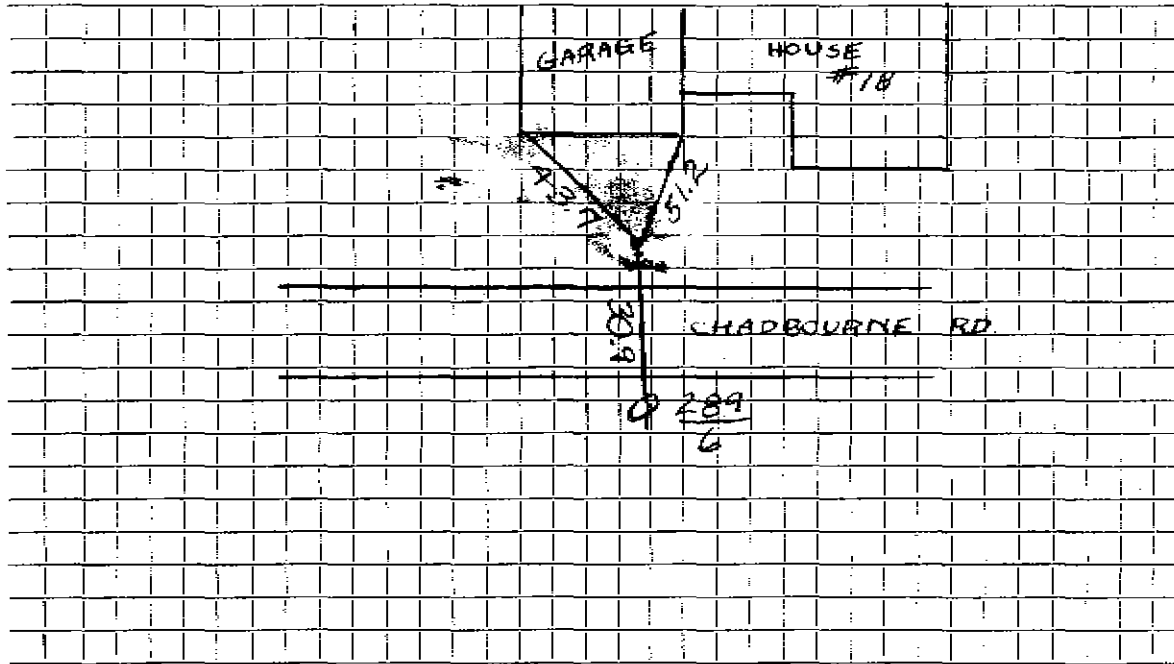

Connection made in ..... Street. Work completed .....

Remarks: .....  
.....  
.....