


DATE _____

TOWN OF LEXINGTON — BOARD OF PUBLIC WORKS

WATER DIVISION

Sketch of Service Here

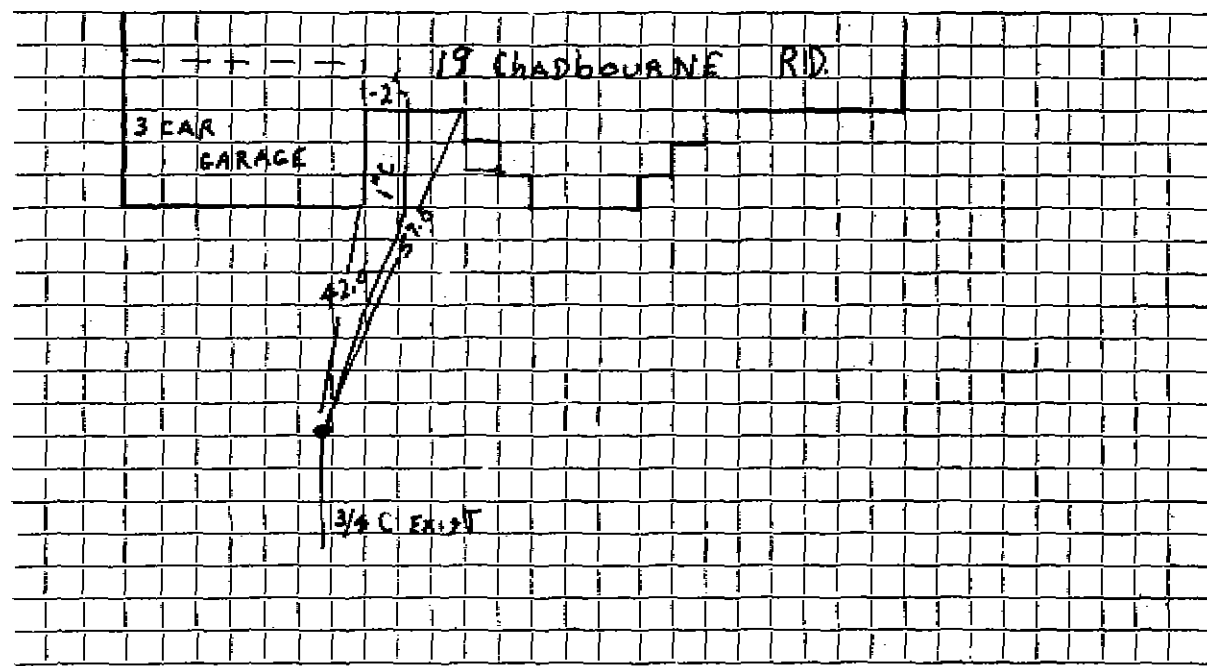

Connection made in Street. Work completed

Remarks:
.....
.....

WATER SERVICE RECORD

Name

Service No.

Address 19 Charbourne Rd.

Location Lexington

Repair Renewal New Service


Date	Material	Amount	Total	Date	Amount
7/24/54	58' 3/4 COPPER 1 3/4 x 1/2 S&W				
					NON CHARGE
				3/14/58 Labor	5 05
				30' - 3/4" Copper Tubing @ .34	10 20
				1-3/4" C. Corn-cock	4 33
				1-3/4" C x 3/4" C. Curb-cock	4 67
				1-Box & Rod	3 90
				1 Hr. Trucking	75
					<u>28 90</u>

DATE _____

TOWN OF LEXINGTON — BOARD OF PUBLIC WORKS

WATER DIVISION

Sketch of Service Here

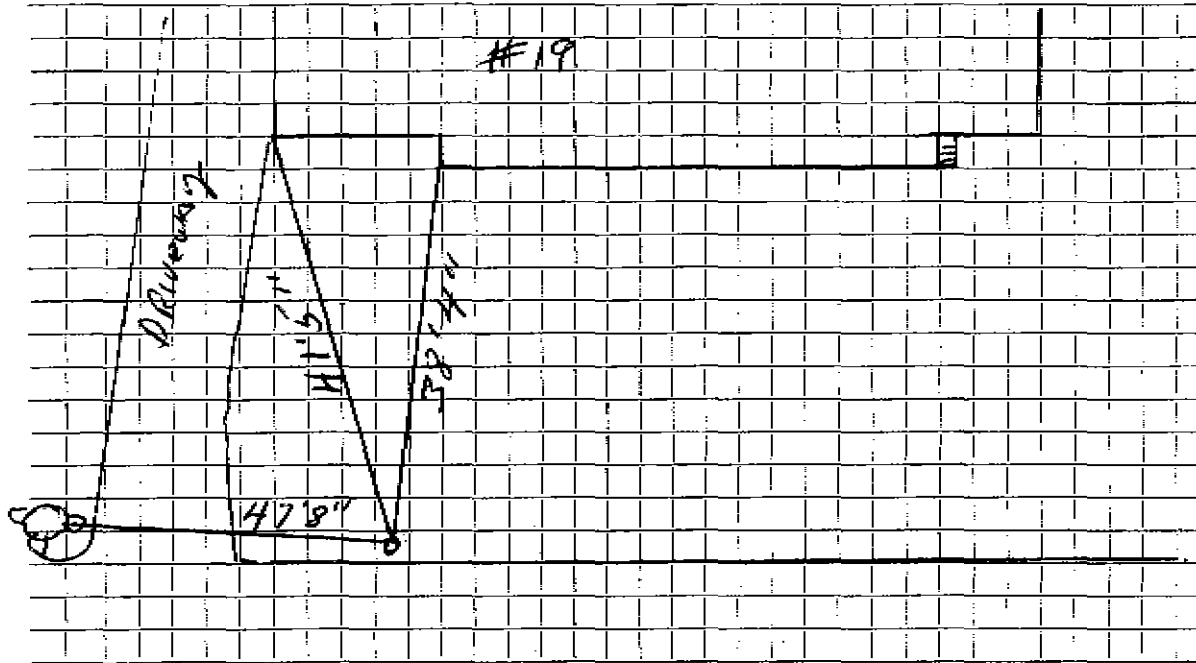

Connection made in Street. Work completed

Remarks:

.....

.....