

WATER SERVICE RECORD

Name

Service No.

Address 21 Charbourne Rd.

Location Lexington

~~Repair or Renewal~~ - New Service


Date	Material	Amount	Total	Date	Amount
8/6/54	50' 3/4 COPPER 3/4 x 1/2 S + W				
					NON CHARGE
				5/12/53 Labor	6 50
				60'-3/4" Copper Tubing @.34	20 40
				1-3/4" C. Corp-cock	4 33
				1-3/4" C x 3/4" C. Curb-cock	4 67
				1-3/4" C x 3/4" C. Union(3 parts)	1 72
				1-Box & Rod	3 90
				1 Hr. Trucking	75
					<u>42 27</u>

DATE _____

TOWN OF LEXINGTON — BOARD OF PUBLIC WORKS

WATER DIVISION

Sketch of Service Here

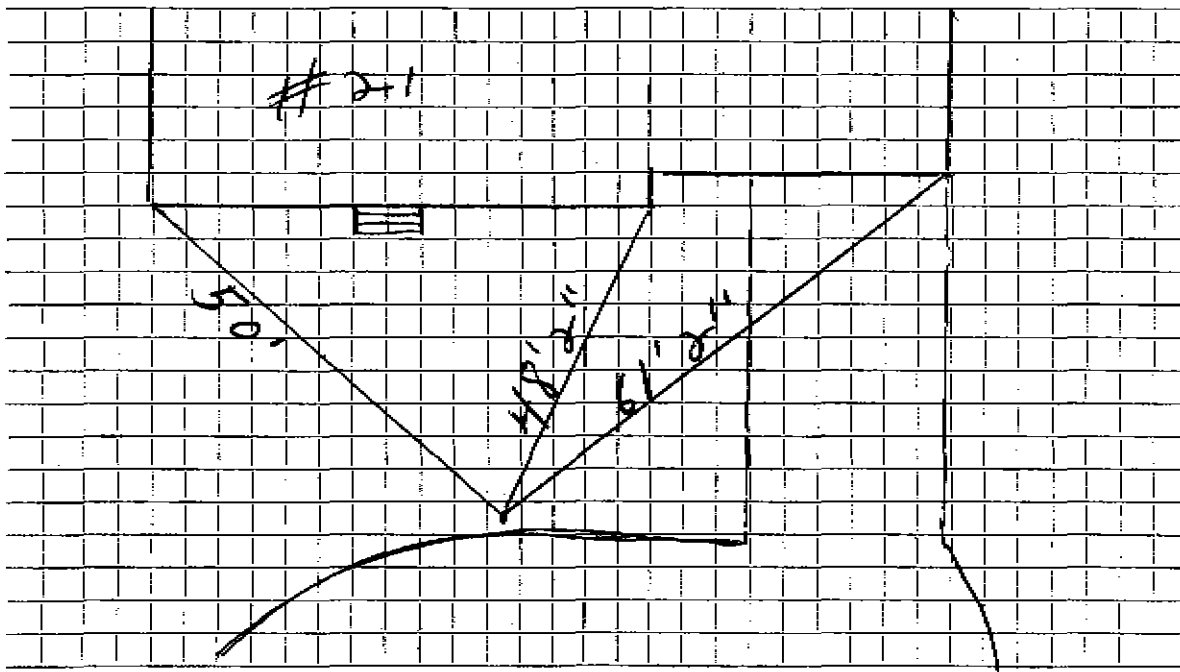

Connection made in Street. Work completed

Remarks:
.....
.....