

WATER SERVICE RECORD

Name Joseph E. Chisholm

Service No. 60

Address 4 Chadbourne Road

Location

~~Repair~~ ~~Renewal~~ New Service John Devine Permit #23

JUN 29 1964


Date	Material	Amount	Total	Date		Amount
6-24-64	29' 3/4" Copper tubing			6-23-64	Deposit ^{GP}	20.54
					NON CHARGE	
				5-13-53	Labor	3.49
					10' 3/4" Copper tubing @ .34	3.40
					1 3/4" C Corp Cock	4.33
					1 3/4" C x 3/4" Curb Cocks	4.67
					1 Box & Rod	3.90
					1 hr. Trucking @ .75	.75
						20.54

TOWN OF LEXINGTON — BOARD OF PUBLIC WORKS

WATER DIVISION

DATE _____

Sketch of Service Here

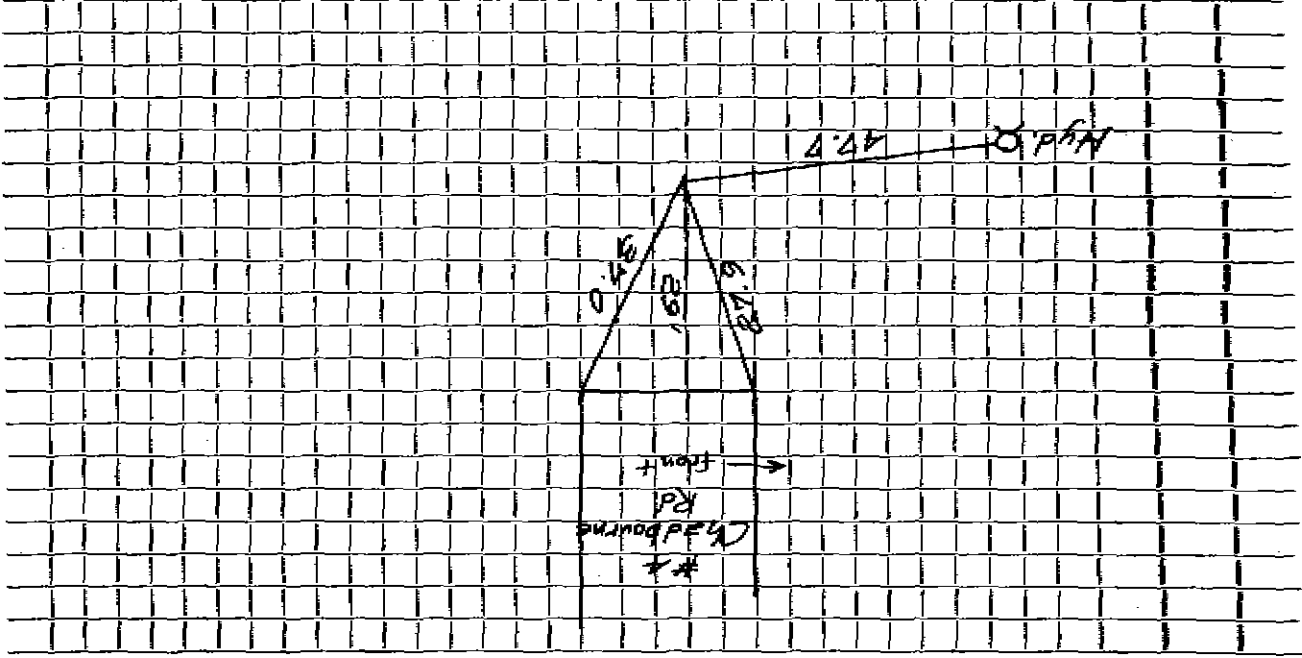

Connection made in _____ Street. Work completed _____

Remarks: _____