
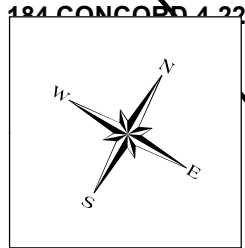


Water Service Tie Card
TOWN OF LEXINGTON
 MASSACHUSETTS

6 Chadbourne Rd

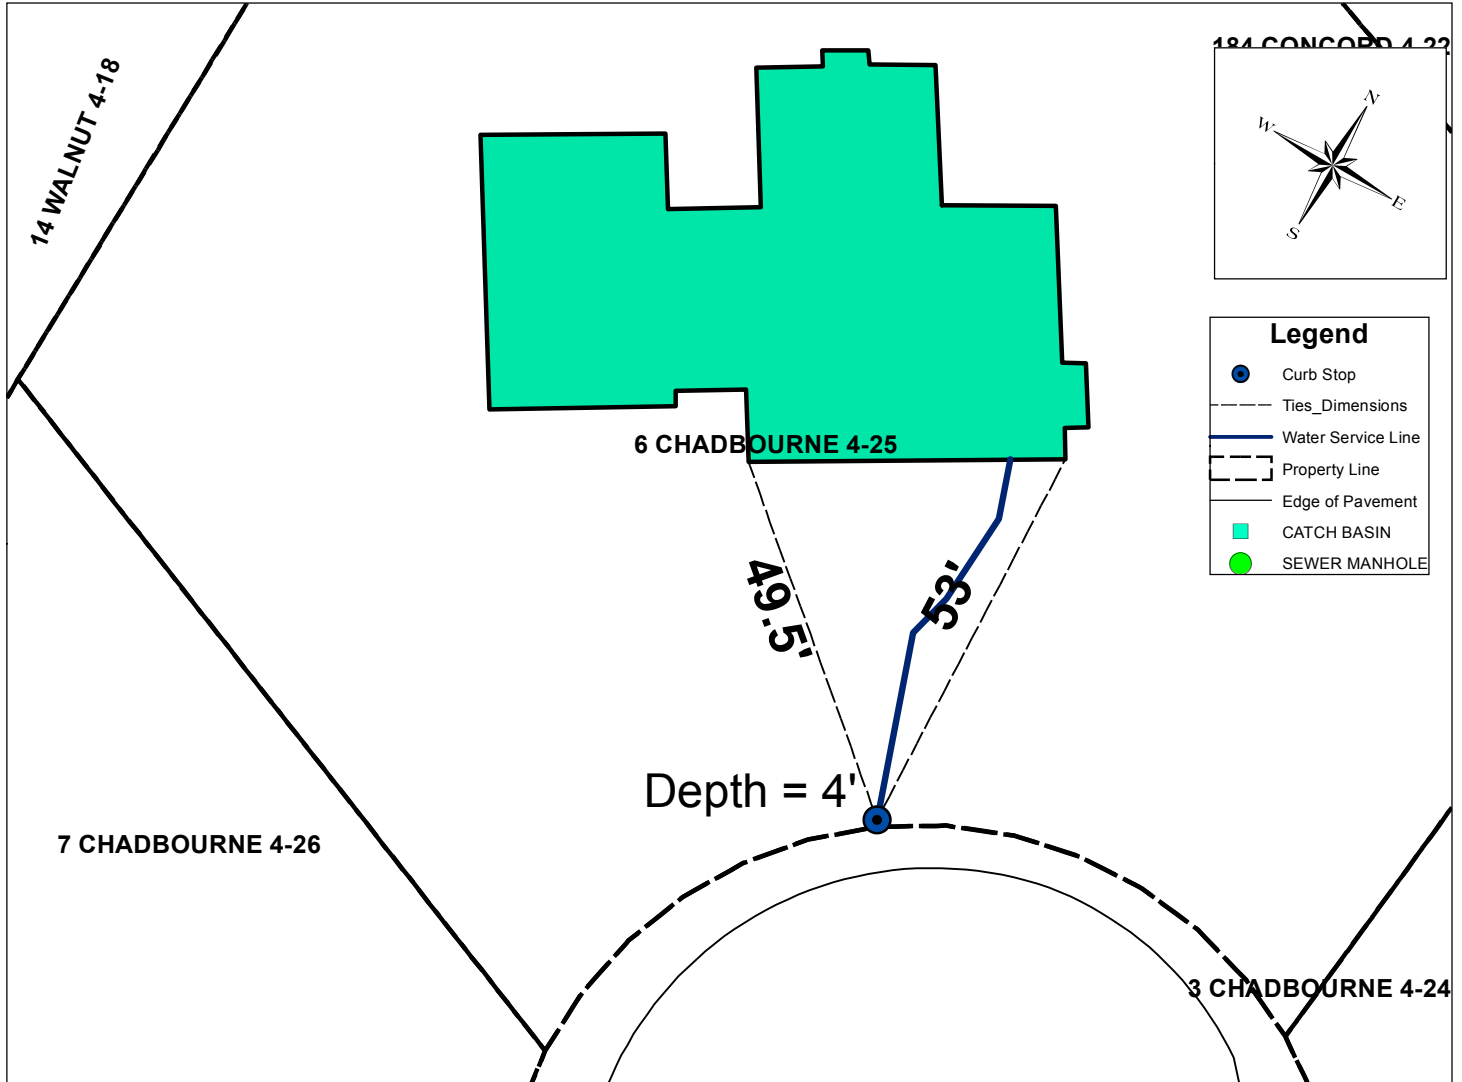

- Legend**
- Curb Stop
 - Ties_Dimensions
 - Water Service Line
 - Property Line
 - Edge of Pavement
 - CATCH BASIN
 - SEWER MANHOLE

Address	Map and Lot	Permit Number	Contractor Name	Inspector
6 Chadbourne Rd	4-25	6033	J Devincent Landscaping	msprague
Date	Material	Depth of Cover	Amount	
12/19/2014	3" Copper type "k"	4 ft	1 ft	
	3" to 1" fitting	4 ft	1	
	1" Copper type "k"	4 ft	1 ft	
	1" Curb Valve and Buffalo Box	4 ft	1	
	1" Copper type "k"		51'	
Type of work completed				

New 1" water service to house from curb stop. New house on lot old house removed.