

WATER SERVICE RECORD

Name Earl Thompson

Service No. 33

Address 7 Chadborne Road

Location

~~Repair Renewal~~ — New Service W.O. #6633 D.C. Const. #3342

NOV 13 1978


Date	Material	Amount	Total	Date		Amount
9-22-78	Labor	57.39		9-18-78	Deposit	160.00
	10% O.H.	5.74	63.13			
1/4	1" Copper tubing @.90		39.60			
1	1" Corp		18.11		OUTSIDE	
1	1" Curb		21.98	1	Box & Rod	11.00
1/4	ton Cold Patch		3.68		Patch 42' x 4'	112.02
1	hr. Trucking		3.00			
1	hr. Loader		4.00			
1	hr. Backhoe		6.50			
			<u>160.00</u>			
9/28/78	99 1/2' 3/4" Copper tubing					

DATE _____

TOWN OF LEXINGTON — BOARD OF PUBLIC WORKS

WATER DIVISION

Sketch of Service Here

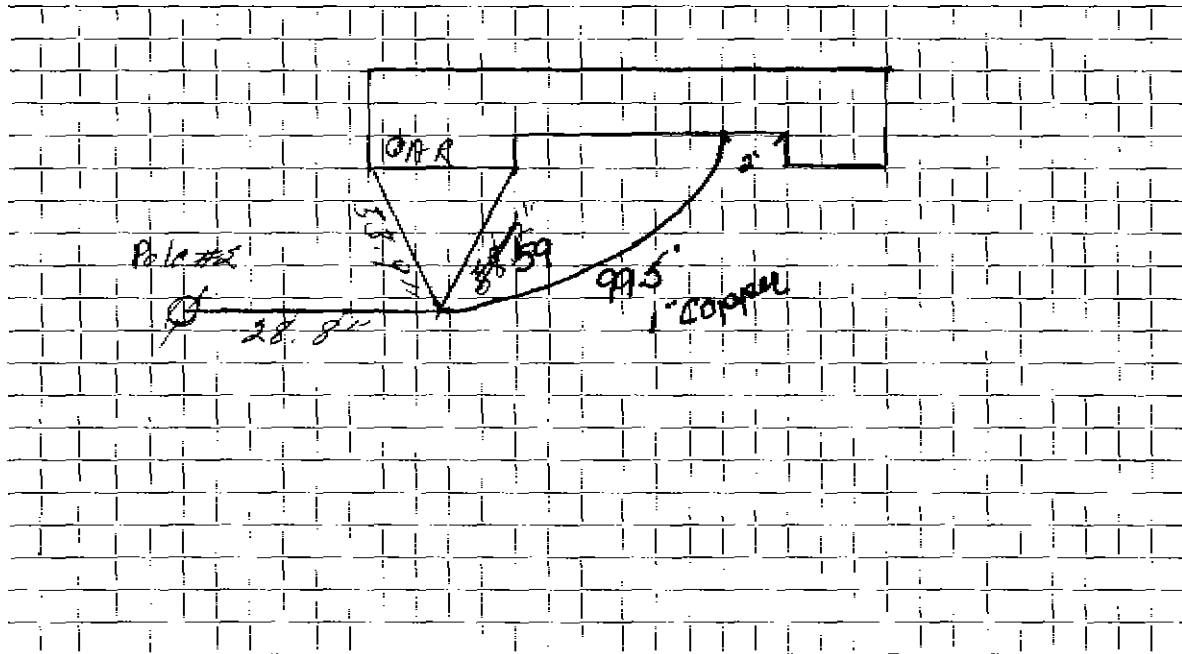

Connection made in Street. Work completed

Remarks:

.....

.....