




DATE 1/5/94

TOWN OF LEXINGTON — BOARD OF PUBLIC WORKS  
WATER DIVISION

Sketch of Service Here

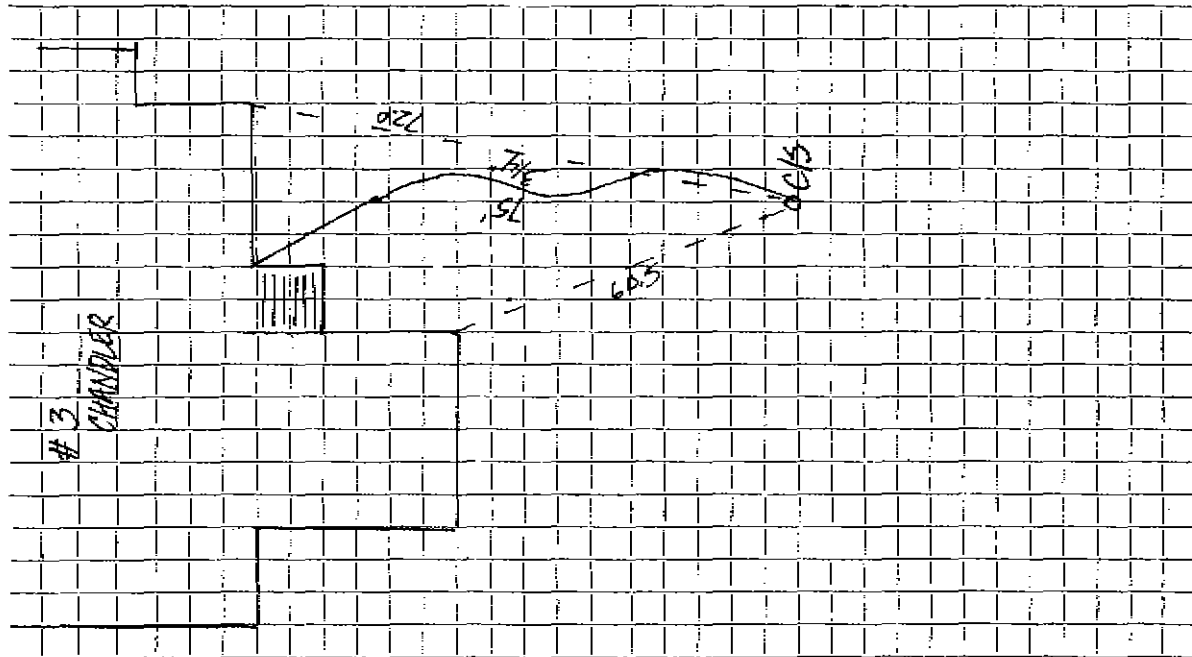

Connection made in ..... Street.

Work completed 12/8/93

DAVE SANTO

Remarks: Copper is set in ledge all the way to main