

WATER SERVICE RECORD

Name Paul Marshall

Service No.

Address 6 Chandler Street

Location

~~Renewal~~ Renewal ~~XXXXXXXX~~ Valeri #4041


Date	Material	Amount	Total	Date	Material	Amount
12/3/81	38' 1" Copper tubing					
	1 1" Wheel Valve					
	1 1 1/2" L.L. Tee & Plug					
	1 1 1/2" x 4" C.L. Nipple				OUTSIDE	
	1 1 1/2" Style 38 Dresser			12/3/81	1 1" Curb Stop	
					1 Box & Rod	
				8/10/82	16' 1" Copper tubing (W.O. #1929)	
					1 1" Lead to copper adapter	
					14 yds. Gravel	
					1 yd. 3/4" Stone	

DATE _____

TOWN OF LEXINGTON — BOARD OF PUBLIC WORKS

WATER DIVISION

Sketch of Service Here

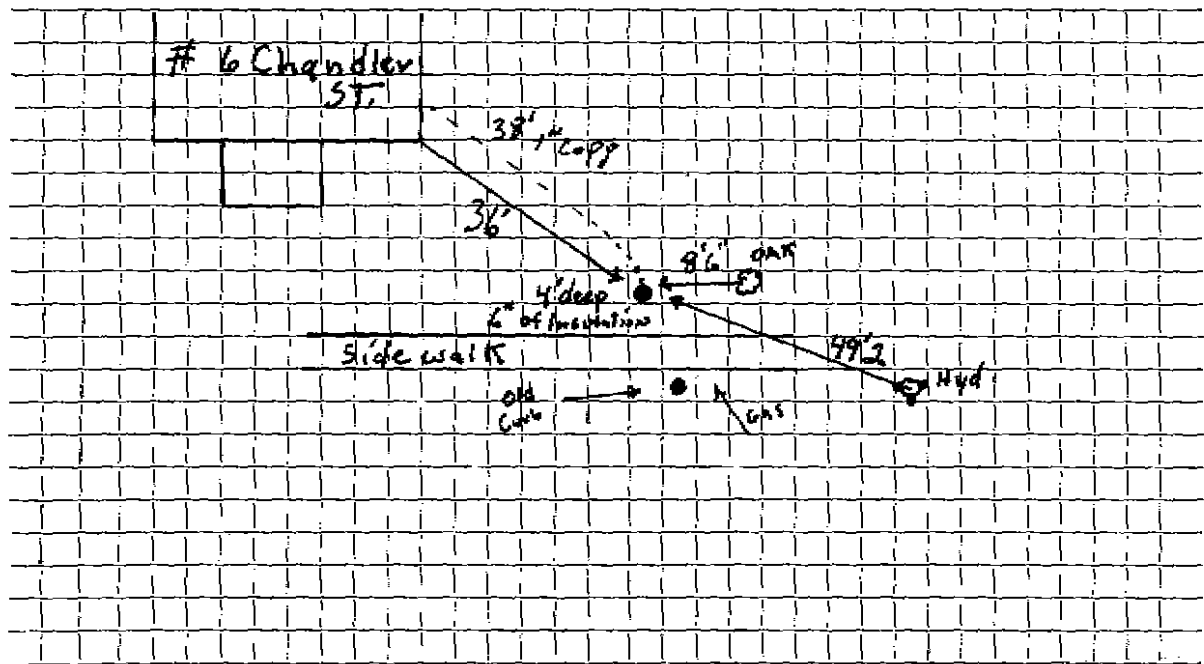

Connection made in Street. Work completed

Remarks:

.....

.....