

## WATER SERVICE RECORD

Name Chisholm Construction Co., Inc.

# 3208

Service No. 98

Address ~~XXXXXX STREET~~ 9 Chandler Street (1965 Per Eng.)

Location W.O. #9143

~~Work Order~~ - New Service Lexington Sewerage Co. Permit #81

DEC 28 1964


Date	Material	Amount	Total	Date	Amount
8-28-64	Labor	4 73		2-21-64	25 00
	10% O.H.	47	5 20	1-5-65	13 87
	9' 3/4" Copper Tubing (H. to C.)		3 78		38 87
	21' 3/4" Copper Tubing (C. to Main)		8 82		
	1 3/4" Corp Cock		7 41		
	1 3/4" Gurb Cock		8 76		
	1 Box & Rod		4 90		
			38 87		
4-16-64	63' 3/4" Copper Tubing				

DATE \_\_\_\_\_

TOWN OF LEXINGTON — BOARD OF PUBLIC WORKS

WATER DIVISION

Sketch of Service Here

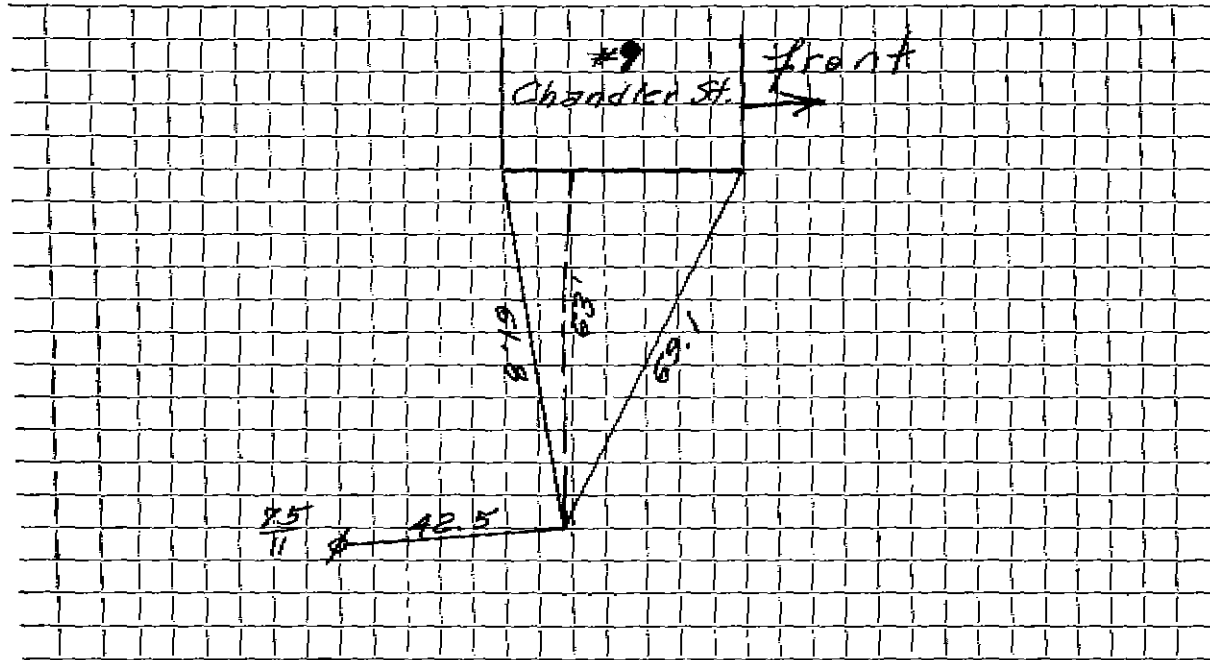

Connection made in ..... Street. Work completed .....

Remarks: .....

.....

.....