


DATE _____

TOWN OF LEXINGTON — BOARD OF PUBLIC WORKS
WATER DIVISION

Sketch of Service Here

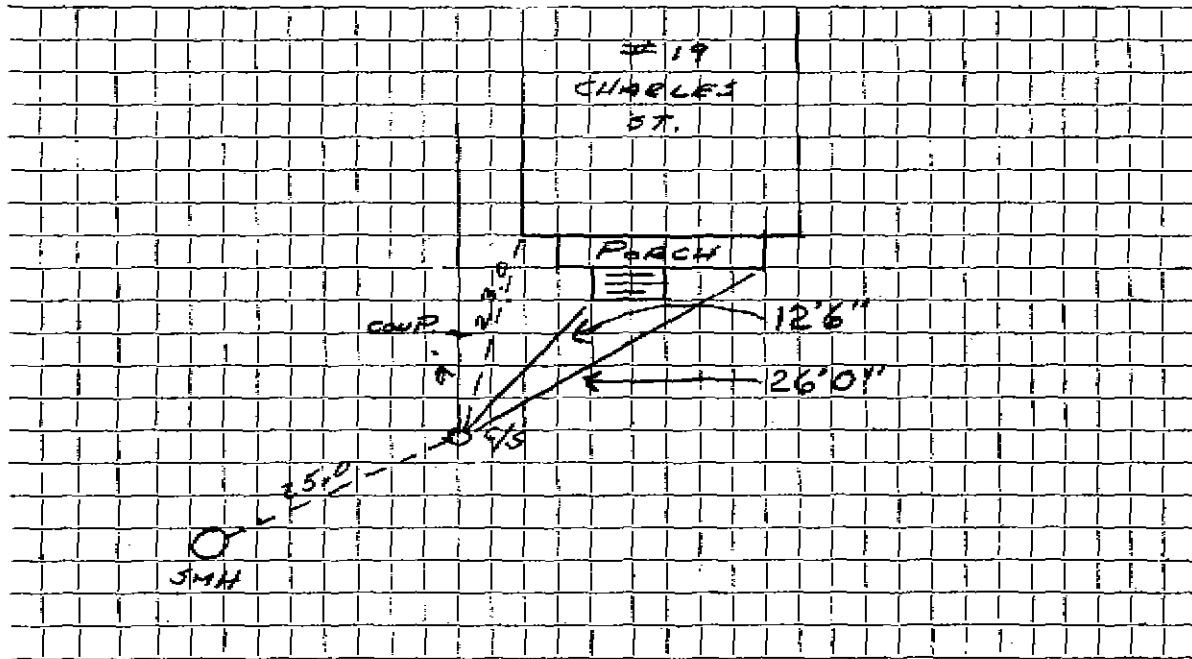

Connection made in CHARLES Street. Work completed

Remarks: RE-NEW C/S & 9 LF 3/4" COPPER - Renewed To Curb. 1938