

WATER SERVICE RECORD

#5313

Name Adam A. Adams

Service No. 178

Address 23 Charles Street

Location

~~Repair - Home work - New Service~~
Renewal

Comm. 1-30-59


Date	Material	Amount	Total	Date	Material	Amount
8-20-59	Labor	23 04		7-1-59	2000	10 00
	10% O. H.	2 30	25 34	11-30-59	Refund	40 21
	52' 3/4" Copper tubing @.41		21 32			59 79
	1 3/4" Cx 3/4" I.W.H. Stop & Waste	5 88			NON CHARGE	
	1 Hr. Town Shovel @6.50		6 50	8-20-59	Labor	41 17
	1 Hr. Trucking @.75		75		14' 3/4" Copper tubing @.41	5 74
			59 79		1 3/4" C Corp Cock	4 67
					1 3/4" C Curb Cock	5 98
					1 Box & Rod	5 00
					1 1/2 Straight Tailpiece	50
					1 1/2 Offset Tailpiece	50
					18 x 3 Patch	18 00
						81 56

DATE _____

TOWN OF LEXINGTON — BOARD OF PUBLIC WORKS

WATER DIVISION

Sketch of Service Here

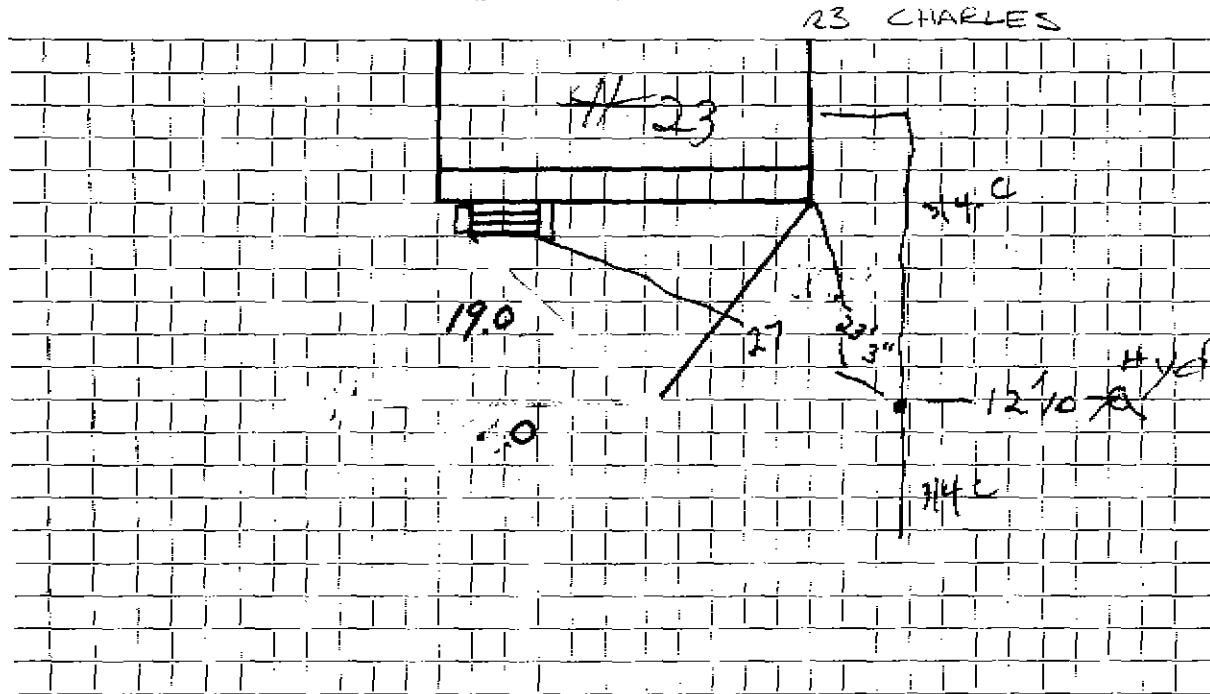

Connection made in Street. Work completed

Remarks:

.....

.....