## WATER SERVICE RECORD

Service No.

Name

Robert Swanson


Loc	ation	27 Charles Street						
Ray	RXXXX	ADAXAL New Service	Arlex #3875					
Date		Material	Amount	Total	Date			Amount
4/17/84	25'	1" Copper					L	<del> </del>
_ <del></del>	<del> </del>	! 						
<del></del>	<del> </del> -		<del>-</del>		- !		OUTSIDE	<del> </del>
					4/17/84	19'e	" I" Copper	<del> </del>
	+	ļ	<u> </u>	ļ 	_	1	1" Corp	<u> </u>
<del>-</del>	<u> </u>	<del> </del>	<del>                               </del>	<u> </u>	<del> +</del>	1	1" Curb Box & Rod	<del> </del>
_ <del></del>	<del></del> -	<u>:</u>	<del>-                                    </del>		<u></u>	<del></del>	BOX & NOU	<del></del>
<del></del>								ļ
	-	<u> </u>		l			<del> </del>	 <del></del>
<del></del>	- <del></del>		<u> </u>	<u> </u>			! 	<del></del>
<del>-</del>		<u> </u>	_ <del>   </del>	 	<del>-    </del>		<u> </u>	<del> </del>
			-+		!! <del></del>		! !	T
	 	<del> </del>	<u> </u>					<u> </u>
	<del> </del>	·	<u> </u>	<u> </u>			<del>                                     </del>	· · · · · · · · · · · · · · · · · · ·
	<del>-</del>	<u> </u>	<del></del>	<del> </del>			<del> </del>	<u> </u>

	_	
_		 -
·	-	 _

## TOWN OF LEXINGTON - BOARD OF PUBLIC WORKS

## WATER DIVISION

## Sketch of Service Here

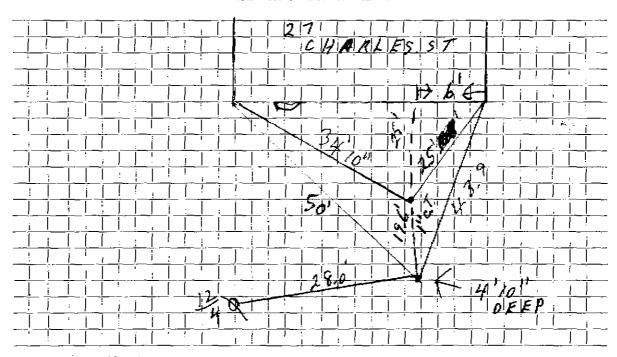

Connection made in Street.	Work completed
Remarks:	